

# Addendum #4 File # 16-0274

**Project: Lakewood Water Treatment Plant HVAC System Improvements** 

This addendum serves to notify all bidders of the following changes to the solicitation documents:

# **NOTICE**

This Addendum is issued to modify, explain or correct the original drawings, specifications and/or previous addendums and is hereby made a part of the Contract Documents.

**PROJECT MANUAL** 

SPECIAL PROVISIONS

SP-10 METHOD ON PAYTMENT

**REPLACE** SP-10, 1. d. i., ii., & iii. with the following:

"SP-10, 1. d. i. Provide and deliver (1) 200 BTU NG Unit Heater to the city of Duluth at the Lakewood Water Treatment Plant (No Installation shall be included). The Gas-fired power-vented propeller unit heater shall be (1) Modine Model PDP-200HE130 Power-Vented Heater, or equal. Natural gas fired unit heater shall be designed for overhead suspended mounting, heater shall only requires venting, gas, and electric service connections prior to operation. Propeller fan units are classified as zero-static-pressure type, and should not be used with velocitygenerating discharge nozzles or ductwork connections. Product shall have CSA Certification for use in the US and Canada 100% shut-off, intermittent pilotignition system with continuous retry, at no extra charge. This ignition system shall allow the unit to be field-converted to liquid propane. The unit shall be 80% thermally efficient. The unit shall have a power exhaust that can be rotated 180degrees. The unit shall be capable of being vented vertically or horizontally. The unit shall be constructed with a blocked vent safety switch, 20 gauge aluminized steel cabinet, 115V control step down transformer with 24V gas controls, Aluminized steel heat exchanger, Aluminized steel burner with stainless steel separator strip Certified to 0.5" W.C., external static pressure single stage standing pilot control system for operation on natural gas, high limit safety control, control terminator board, adjustable motor sheaves on blower models, and Totally enclosed fan/blower motor."

# DIVISION 09 96 00 - Finishes

Section 09 96 00 - High Performance Coatings:

**CLARIFICATION** it is not the intent of this project to repaint all areas of the Lakewood WTP. It is the intent to paint the new materials and areas of the WTP that the majority work is occurring. It is not the intent of the work included in the project to paint new materials that are minor renovations. Refer to direction provided on the drawings, specification, and Finish Schedule Provided on E-23R.

# DIVISION – 23 HEATING, VENTILATING, AND AIR CONDITIONING (HVAC)

Section 23 98 50 – HVAC Sequence of Operation: Sub-paragraph 3.02.G.

ADD clarification as follows: "System switches for EF-2 and EF-3 in Chlorine Feed and Chlorine Storage Rooms to be housed in NEMA 4X enclosures."

Section 23 21 30 - Hydronic Heat Transfer Equipment: Paragraph 2.01.A and 2.02.A

**ADD** SIGMA, Airtherm and Vulcan as an approved manufacturer.

Section 23 73 30 – Air-To-Air Energy Recovery Ventilators, Paragraph 2.01.A

**ADD** Greenheck as an approved manufacturer.

# **DIVISION 26 – ELECTRICAL**

All Sections

# **CLARIFICATION**

the CONTRACTOR may ignore references to specification and details that are not included in the Contract Documents. For example 26 90 00 is not included in this project. For clarification refer to Drawing Table of Contents and Project Manual Table of Content(s).

Section 26 23 29.16 Adjustable Frequency Drive – HVAC

# **CLARIFICATION**

it is the intent that the integrated and controlled equipment motor control including but not limited to Adjustable/Variable Frequency Drives shall be coordinate and provide with the equipment. All VFD's on the project shall be coordinated to be by the same manufacture. Refer to drawings and schedules for additional information. The project shall furnish and install

ADDENDUM #4 March 25, 2016 Page 3 of 4

all equipment for a complete and operable system as described by the Contract Documents.

Section 26 28 19 - Enclosed Switches

**DELETE** paragraph 26 28 19, 2.03.

# **DRAWINGS**

Drawing G-2 **REPLACE** with the attached G-2R

Drawing PM-1 Mechanical Floor Plan

**CLARIFICATION** the work included under this contract shall furnish and install (2) new

sample pumps, rather than relocated the existing. The contractor shall still remove the existing sample pumps. The contractor shall adjust project

scope and notes accordingly. Coordinate with all disciplines.

**REPLACE** Key Note 1 with the following: "Furnish and install new sample pumps SP-

1 and SP-2. Sample pumps shall be Goulds MCC Series General Purpose Centrifugal Pump, or equal. The pump shall be 1-1/4" x 1" cast-iron pump with a continuous duty premium Efficient TEFC ¾ horsepower 1-phase motor. Pump shall develop approximately ~82' TDH at deadhead

condition and ~46' TDH at 40 gpm."

**REPLACE** Key Note 3 with the following: "Remove existing SP-1, turn-over to the

OWNER. Furnish and install new sample pump SP-1 (Complete).

Relocate/Replace the electrical connection and control."

**REPLACE** Key Note 4 with the following: "Remove existing SP-2, turn-over to the

OWNER. Furnish and install new sample pump SP-2 (Complete).

Relocate/Replace the electrical connection and control."

with the attached E-3R Drawing E-3 REPLACE with the attached E-6R Drawing E-6 REPLACE with the attached E-7R Drawing E-7 **REPLACE** Drawing E-8 **REPLACE** with the attached E-8R Drawing E-10 REPLACE with the attached E-10R Drawing E-14 REPLACE with the attached E-14R Drawing E-15 REPLACE with the attached E-15R

# LAKEWOOD WTP HVAC SYSTEM IMPROVMENTS CITY OF DULUTH

ADDENDUM #4 March 25, 2016 Page 4 of 4

Drawing E-16	REPLACE	with the attached E-16R
Drawing E-17	REPLACE	with the attached E-17R
Drawing E-18	REPLACE	with the attached E-18R
Drawing E-19	REPLACE	with the attached E-19R
Drawing E-22	REPLACE	with the attached E-22R
Drawing E-23	REPLACE	with the attached E-23R
Drawing E-24	REPLACE	with the attached E-24R
Drawing E-25	REPLACE	with the attached E-25R
Drawing E-26	REPLACE	with the attached E-26R

Please acknowledge receipt of the Addendum by initially and dating Addendum #4 below the bid form on the invitation for bids.

Posted March 25, 2016

**END OF ADDENDUM** 

# SHEET INDEX

TITLE SHEET G-2R SHEET INDEX

G-3 LEGEND, SYMBOLS, & ABBREVIATIONS

### C - CIVIL

C-1 SITE PLAN C-2 SITE PHOTOS

### A-ARCHITECTURAL

ENLARGED FIRST FLOOR PLAN SOUTH A-2 ENLARGED FIRST FLOOR PLAN NORTH

A-3 ENLARGED SECOND FLOOR PLAN

ROOF PLAN A-4

A-5 SECTION AND DETAILS

A-6 DETAILS

### M-MECHANICAI

M1.0 MECHANICAL SYMBOLS, & ABBREVIATIONS M2.1 FIRST FLOOR SOUTH MECHANICAL DEMOLITION M2.2 FIRST FLOOR NORTH MECHANICAL DEMOLITION M2.3 SECOND FLOOR SOUTH MECHANICAL DEMOLITION M2.4 SECOND FLOOR NORTH MECHANICAL DEMOLITION M2.5 ROOF MECHANICAL DEMOLITION M3.1 FIRST FLOOR SOUTH HEATING/COOLING PIPING M3.2 FIRST FLOOR NORTH HEATING/COOLING PIPING M3.3 SECOND FLOOR SOUTH HEATING/COOLING PIPING M4.1 FIRST FLOOR SOUTH DUCTWORK FIRST FLOOR NORTH DUCTWORK M4.2 SECOND FLOOR SOUTH DUCTWORK M4.3 M4.4 SECOND FLOOR NORTH DUCTWORK M4.5 ROOF MECHANICAL PLAN M5.1 MECHANICAL ROOM PARTIAL PLAN M5.2 MECHANICAL ROOM PARTIAL PLAN M5.3 MECHANICAL ROOM PARTIAL PLAN M5.4 EAST ELEVATION PARTIAL PLAN RAPID MIX ROOM PARTIAL PLAN M5.5 M6.1 MECHANICAL DETAILS M6.2 MECHANICAL DETAILS

M7.1

M7.2

FIRST FLOOR SOUTH MECHANICAL PLAN DEMOLITION PM-1 PM-2 FIRST FLOOR SOUTH MECHANICAL PLAN

MECHANICAL EQUIPMENT SCHEDULES

MECHANICAL EQUIPMENT SCHEDULES

PM-3 SAMPLE PUMP PIPING DIAGRAM SAMPLE PUMP PIPING PHOTOS

### E - ELECTRICAL

**ELECTRICAL SYMBOLS, & ABBREVIATIONS** E-1 **ELECTRICAL SYMBOLS. & ABBREVIATIONS** F-2 FIRST FLOOR SOUTH ELECTRICAL DEMO F-3R E-4 FIRST FLOOR NORTH ELECTRICAL DEMO E-5 SECOND FLOOR SOUTH ELECTRICAL DEMO F-6R SECOND FLOOR NORTH ELECTRICAL DEMO E-7R ROOF ELECTRICAL DEMO E-8R FIRST FLOOR SOUTH HEATING/COOLING ELECTRICAL PLAN E-9 FIRST FLOOR NORTH HEATING/COOLING ELECTRICAL PLAN F-10R SECOND FLOOR SOUTH HEATING/COOLING FLECTRICAL PLAN E-11 FIRST FLOOR SOUTH DUCTWORK ELECTRICAL PLAN E-12 FIRST FLOOR NORTH DUCTWORK ELECTRICAL PLAN E-13 SECOND FLOOR SOUTH DUCTWORK ELECTRICAL PLAN SECOND FLOOR NORTH DUCTWORK ELECTRICAL PLAN F-14R E-15R ELECTRICAL ROOF PLAN E-16R PARTIAL ELECTRICAL PLANS

PROCESS RISER DIAGRAM E-20 E-21 **ELECTRICAL PHOTOS** 

E-17R

F-18R

E-19R

E-22R ELECTRICAL SCHEDULES NO. 1 E-23R ELECTRICAL SCHEDULES NO. 2

ONE-LINE DIAGRAM

ONE-LINE DIAGRAM NO. 2

ONE-LINE DIAGRAM FOR POWER SUPPLY

E-24R ELECTRICAL SCHEDULES NO. 3 F-25R **ELECTRICAL SCHEDULES NO. 4** 

E-26R ELECTRICAL SCHEDULES NO. 5 E-27 ELECTRICAL DETAILS NO. 1 E-28 ELECTRICAL DETAILS NO. 2


E-29 ELECTRICAL DETAILS NO. 3

## DISCIPLINE IDENTIFICATION


DESIGNATION	DISCIPLINE
G C	GENERAL SITE CIVIL
Ř	REMOVAL/DEMOLITION
S PM	STRUCTURAL MECHANICAL
PP	UTILITY PLAN & PROFILE
A	ARCHITECTURAL
M	PLUMBING/HVAC
E	ELECTRICAL

NOTE: FOR CLARITY, IN A FEW LOCATIONS PORTIONS OF WORK FOR A DISCIPLINE MAY BE SHOWN ON SHEET WITH A DIFFERENT DISCIPLINE DESIGNATION. IT IS THE RESPONSIBILITY OF THE GENERAL CONTRACTOR TO PROVIDE A COMPLETE AND OPERABLE SYSTEM.


# PLAN VIEW LABEL

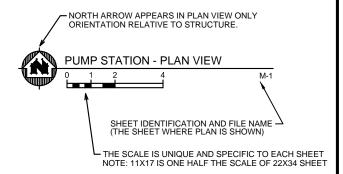


# SHEET IDENTIFICATION NUMBERING EXAMPLE

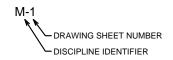

# SECTION DESIGNATION

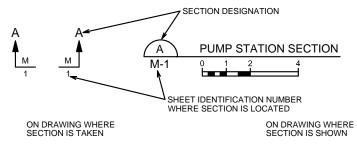

# **DETAIL DESIGNATION**

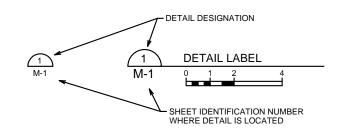

ON DRAWING WHERE DETAIL IS TAKEN

ON DRAWING WHERE DETAIL IS SHOWN

SHEET INDEX

PROJECT NO.:	00616097	SCALE: AS SHOWN	NO.	DATE	REVISION	BY	THE
PROJECT DATE:	MARCH 2016	DRAWN BY: INIT		3/25	ADDENDUM #1		SUF
F.B. :		CHECKED BY: SRC					
							4 —

IEREBY CERTIFY THAT THIS PLAN. REPORT. OR SPECIFICATION WAS PREPARED BY ME OR UNDER MY DIRE UPERVISION AND THAT I AM A DULY LICENSED PROFESSIONAL ENGINEER UNDER THE LAWS OF THE STATE OF MINNESOT fatt R. Chilin MARCH 25, 2016 44287


Date


License No.


NAL SULTES

AKEWOOD WTP HVAC SYSTEM IMPROVEMENTS CITY OF DULUTH LAKEWOOD, MN

00616097 G-2R

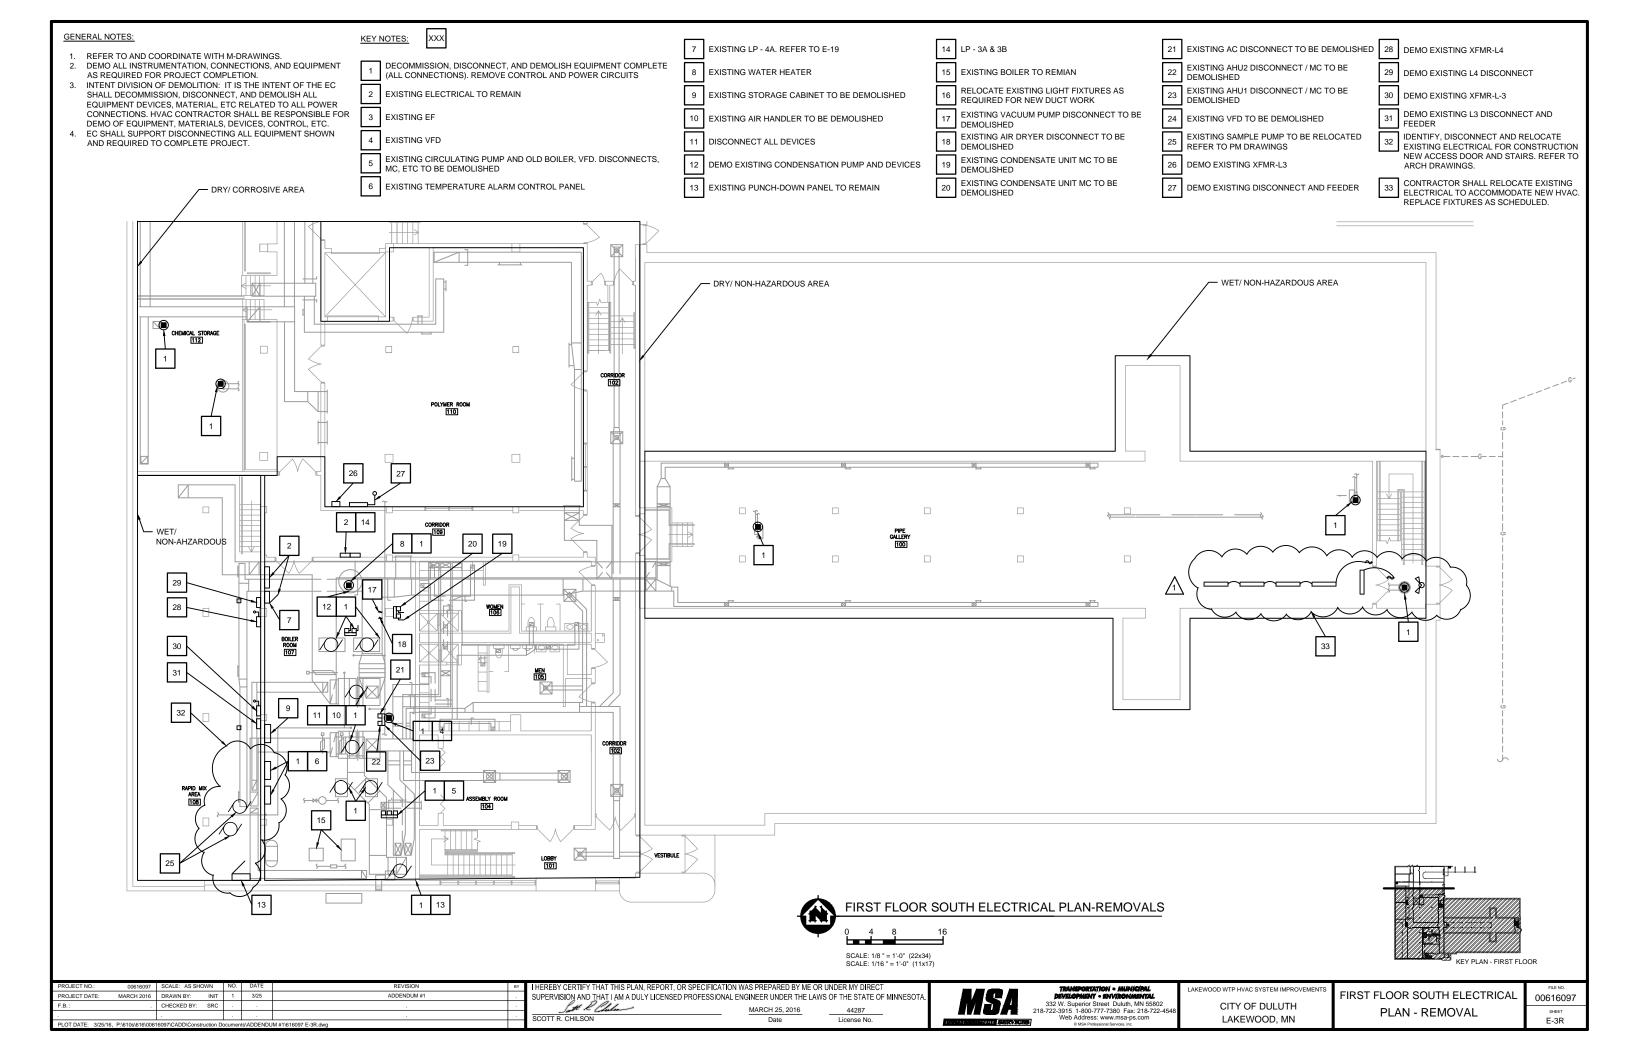

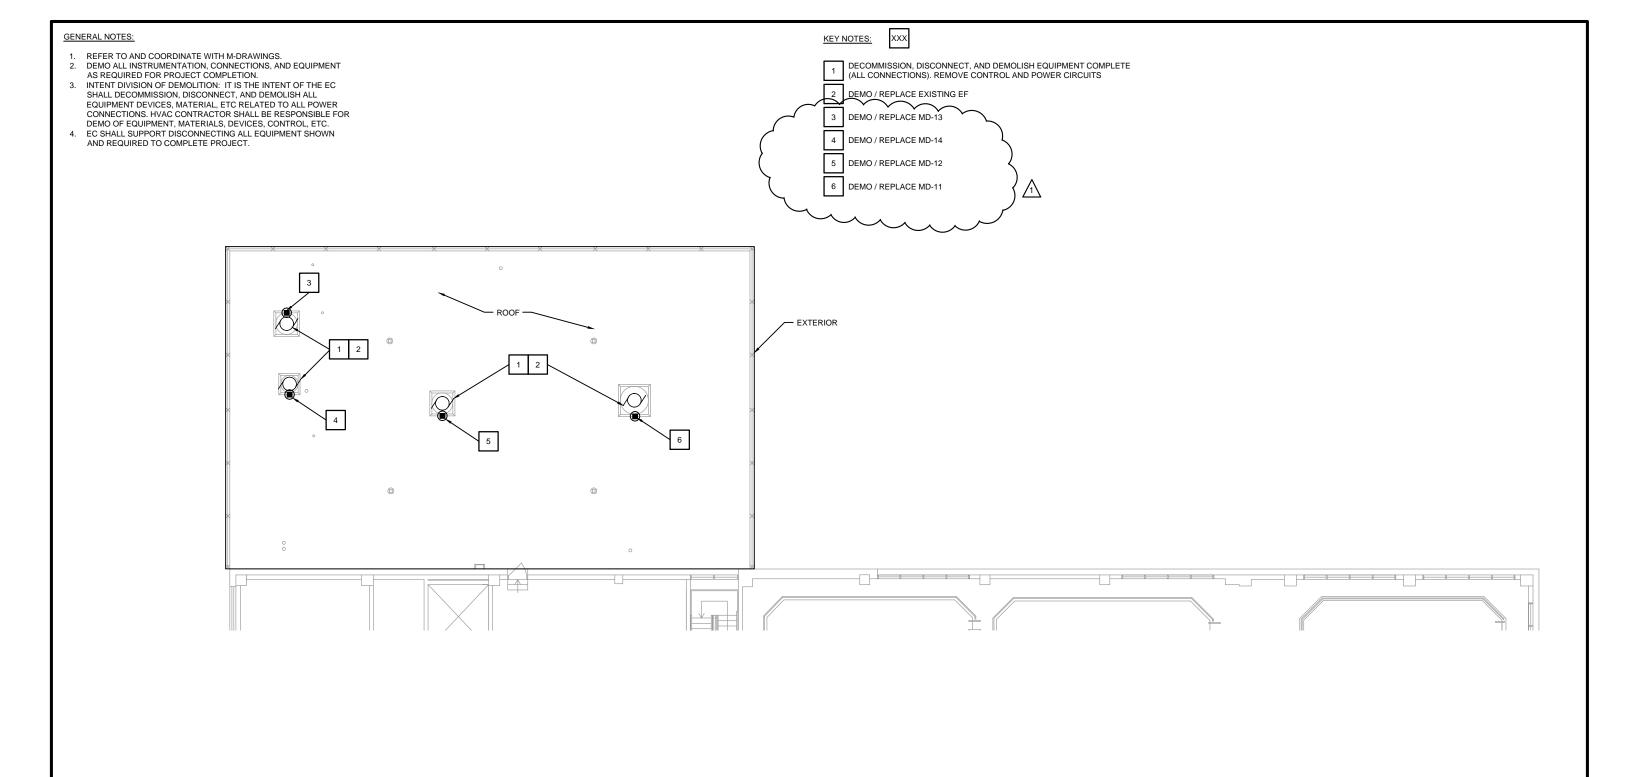

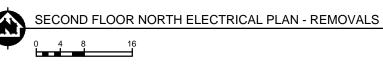

SCALE: 1/8 " = 1'-0" (22x34) SCALE: 1/16 " = 1'-0" (11x17)

PROJECT NO.:	00616097	SCALE: AS SHOWN	NO.	DATE	REVISION	BY				
PROJECT DATE:	MARCH 2016	DRAWN BY: INIT	1	3/25	ADDENDUM #1					
F.B. :		CHECKED BY: SRC								
PLOT DATE: 3/25/16, P:\610s\616\00616097\CADD\Construction Documents\ADDENDUM #1\616097 E-6R.dwg										

Υ	I HEREBY CERTIFY THAT THIS PLAN, REPORT, OR SPECIFICA	T <b>I</b> ON WAS PREPARED BY ME OF	R UNDER MY DIRECT	
	SUPERVISION AND THAT I AM A DULY LICENSED PROFESSION	NAL ENGINEER UNDER THE LAW	S OF THE STATE OF	MINNESOTA.
	Satt & Chilan	MARCH 25, 2016	44287	
	SCOTT R. CHILSON	Date	License No	

	M	S	A
Para	251 5570	MAL 🗵	ERVICES


TRANSPORTATION - MUNICIPAL DEVELOPMENT - ENVIRONMENTAL	LAK
332 W. Superior Street Duluth, MN 55802	1
722-3915 1-800-777-7380 Fax: 218-722-4548	1
Web Address: www.msa-ps.com	1
© MSA Professional Services, Inc.	1

KEWOOD WTP HVAC SYSTEM IMPROVEMENTS CITY OF DULUTH LAKEWOOD, MN

SECOND FLOOR NORTH ELECTRICAL PLAN - REMOVLAS


00616097 SHEET E-6R


I HEREBY CERTIFY THAT THIS PLAN, REPORT, OR SPECIFICAT	TON WAS PREPARED BY ME OR	UNDER MY DIRECT
SUPERVISION AND THAT I AM A DULY LICENSED PROFESSION	IAL ENGINEER UNDER THE LAW	S OF THE STATE OF MINNESOTA.
Satt & Clalin	MARCH 25, 2016	44287

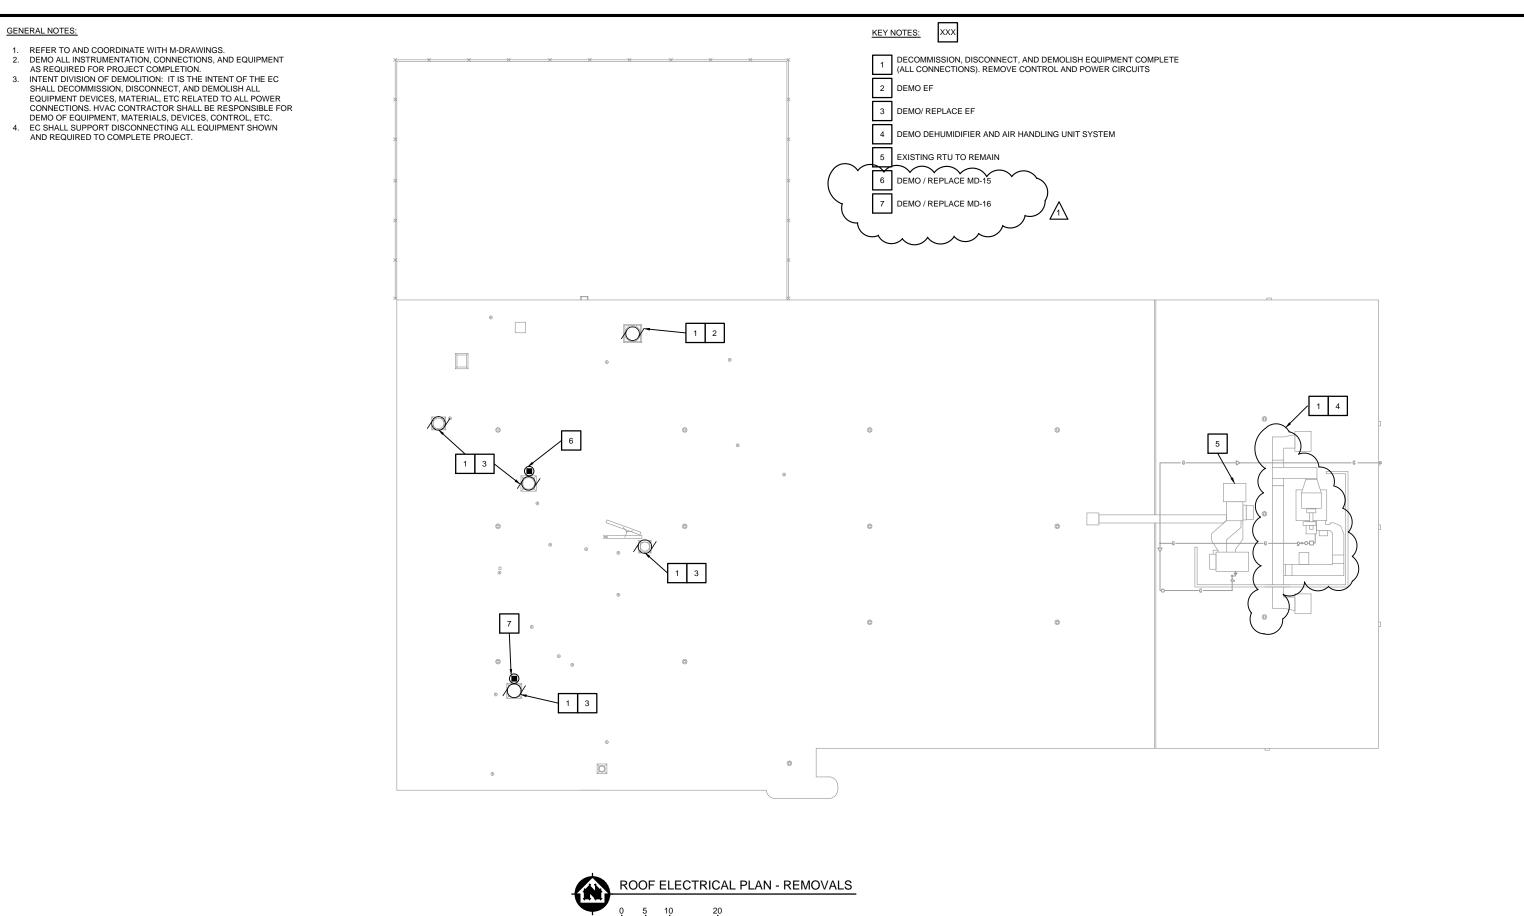

	ROOF ELECTRICAL PLAIN - REIVIOVAL
	0 5 10 20
	SCALE: 3/32 " = 1'-0" (22x34) SCALE: 3/64 " = 1'-0" (11x17)


PROJECT NO.:	00616097 SCALE: AS SHOWN	NO. DATE	REVISION	BY	I HEREBY CERTIFY THAT THIS PLAN, REPORT, OR SPECIFICATION	ION WAS PREPARED BY ME O	R UNDER MY DIRECT		TRANSPORTATION - MUNICIPAL	LAKEWOOD WITH HIVAC SYSTEM IMPROVEMENTS		FILE NO.
PROJECT DATE:	MARCH 2016 DRAWN BY: INIT	1 3/25	ADDENDUM #1		SUPERVISION AND THAT I AM A DULY LICENSED PROFESSIONA	AL ENGINEER UNDER THE LAV	WS OF THE STATE OF MINNESOTA.		DEVELOPMENT • ENVIRONMENTAL	EAREWOOD WIT TWACGTOTEM IMIT ROVEMENTO	ROOF ELECTRICAL PLAN - REMOVALS	00616097
F.B. :	. CHECKED BY: SRC				LA R. Clalin	MARCH 25, 2016	44297	MSA	332 W. Superior Street Duluth, MN 55802 218-722-3915 1-800-777-7380 Fax: 218-722-4548		ROOF ELECTRICAL PLAN - REMOVALS	
					SCOTT R. CHILSON	Data	License No			LAKEWOOD, MN		SHEET
PLOT DATE: 3/25/1	6, P:\610s\616\00616097\CADD\Construction Doc	uments\ADDEN	DUM #1\616097 E-7R.dwg		00011111011120011	Date	Licerise No.	TROPISSIONAL STRATER	© MSA Professional Services, Inc.	LAIRE VIOOD, IVIIV		E-7K

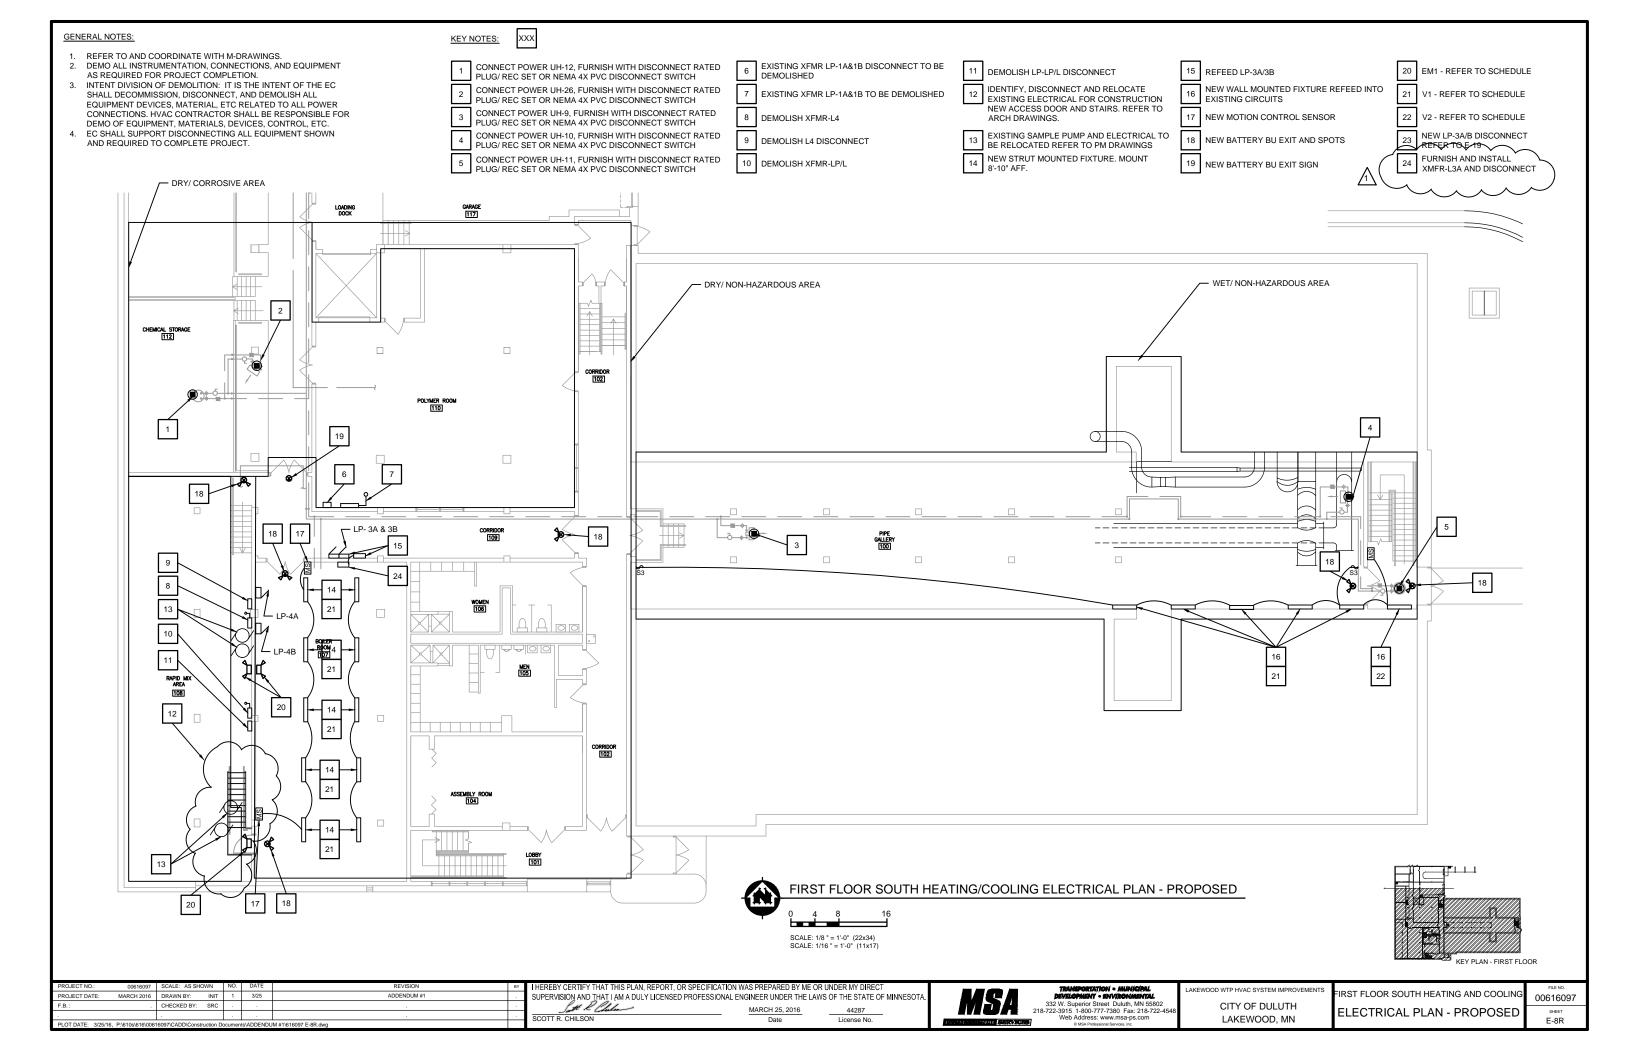


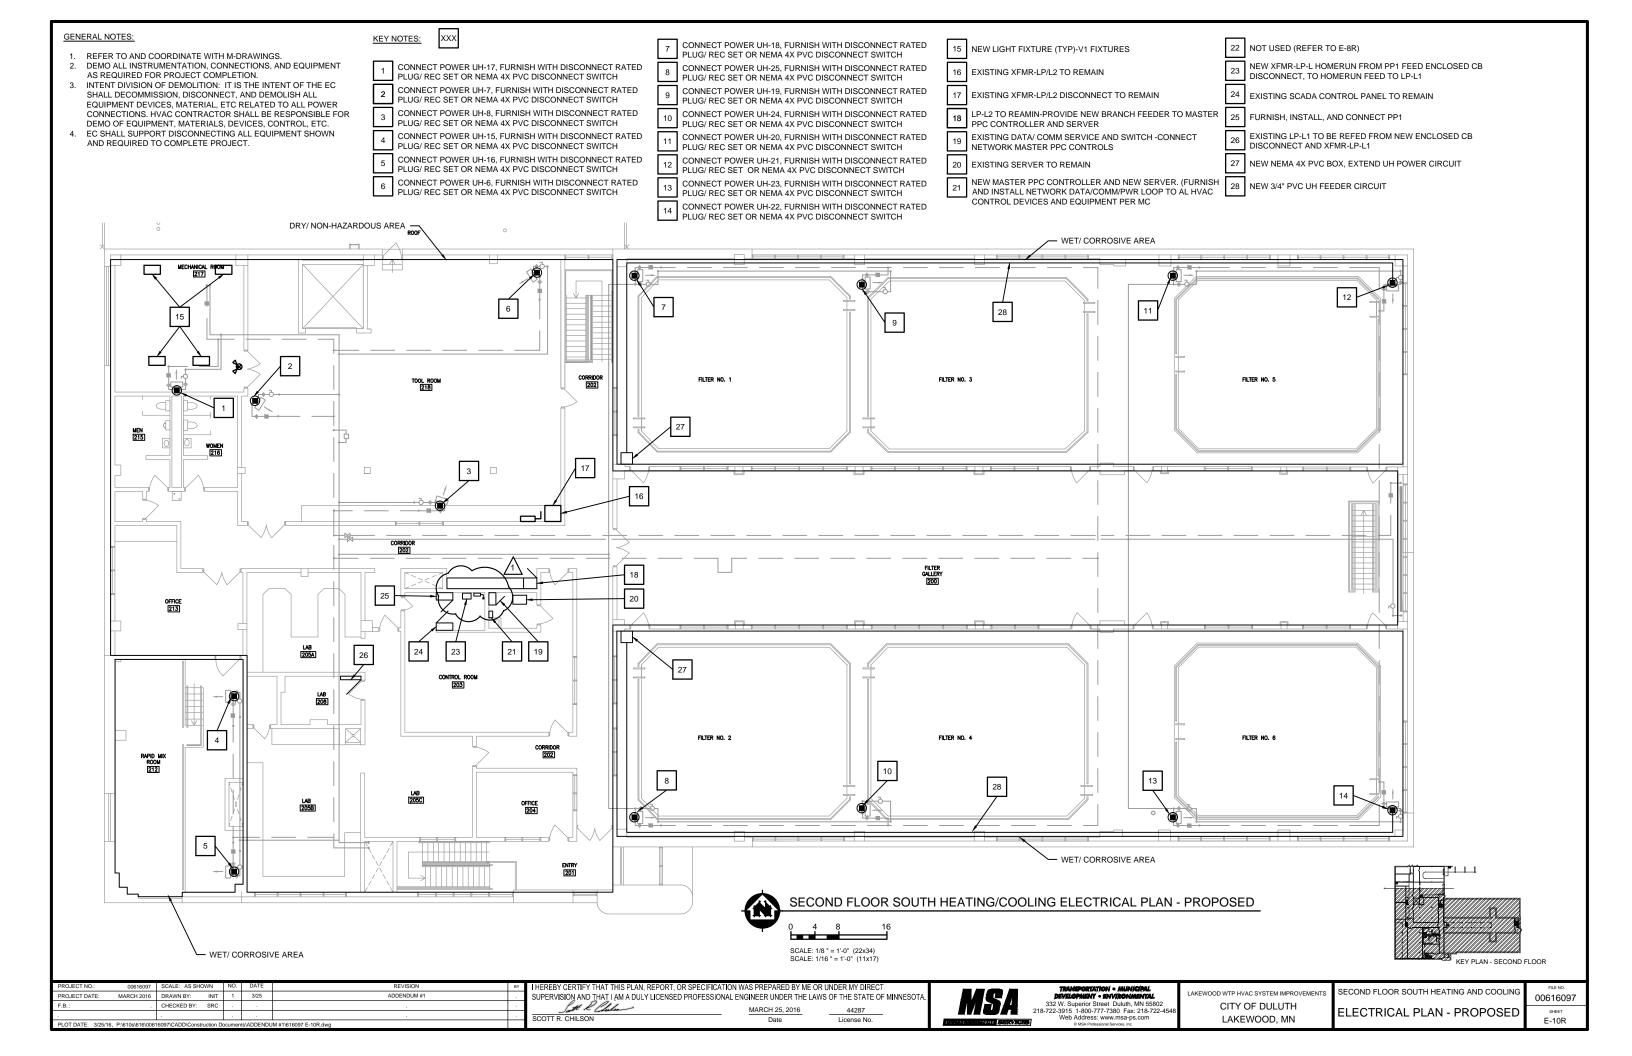



# GENERAL NOTES:

- 1. REFER TO AND COORDINATE WITH M-DRAWINGS.
- DEMO ALL INSTRUMENTATION, CONNECTIONS, AND EQUIPMENT AS REQUIRED FOR PROJECT COMPLETION.
- 3. INTENT DIVISION OF DEMOLITION: IT IS THE INTENT OF THE EC SHALL DECOMMISSION, DISCONNECT, AND DEMOLISH ALL EQUIPMENT DEVICES, MATERIAL, ETC RELATED TO ALL POWER CONNECTIONS. HVAC CONTRACTOR SHALL BE RESPONSIBLE FOR DEMO OF EQUIPMENT, MATERIALS, DEVICES, CONTROL, ETC.
- 4. EC SHALL SUPPORT DISCONNECTING ALL EQUIPMENT SHOWN AND REQUIRED TO COMPLETE PROJECT.

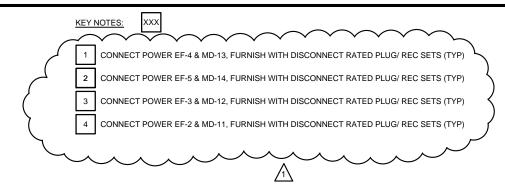


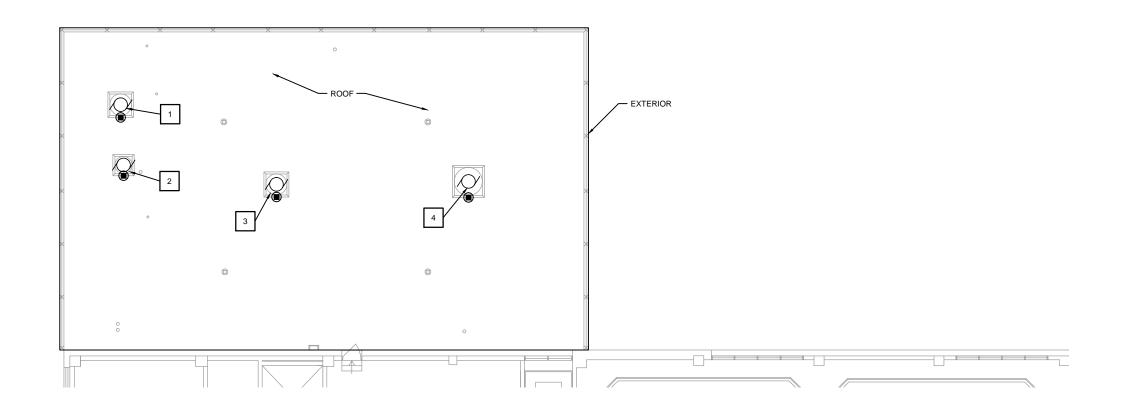

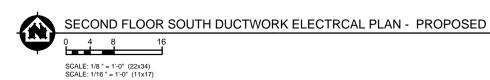


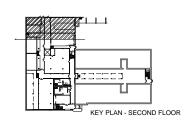



PROJECT NO: 00816097 SCALE: AS SHOWN NO. DATE REVISION BY THEREBY CERTIFY THAT THIS PLAN, REPORT, OR SPECIFICATION WAS PREPARED BY ME OR UNDER MY DIRECT  PROJECT DATE: MARCH 2016 DRAWN BY: INIT 1 325  F.B.: CHECKED BY: SRC :		
	DECOND LEGGINOR HORT	TH DUCTWORK 00616097
F.B.: CHECKED BY: SRC	LUTH	
SCOTT R. CHILSON Date License No. Web Address: www.sa-ps.com   AK	D, MN ELECTRICAL PLAN -	- PROPOSED   SHEET

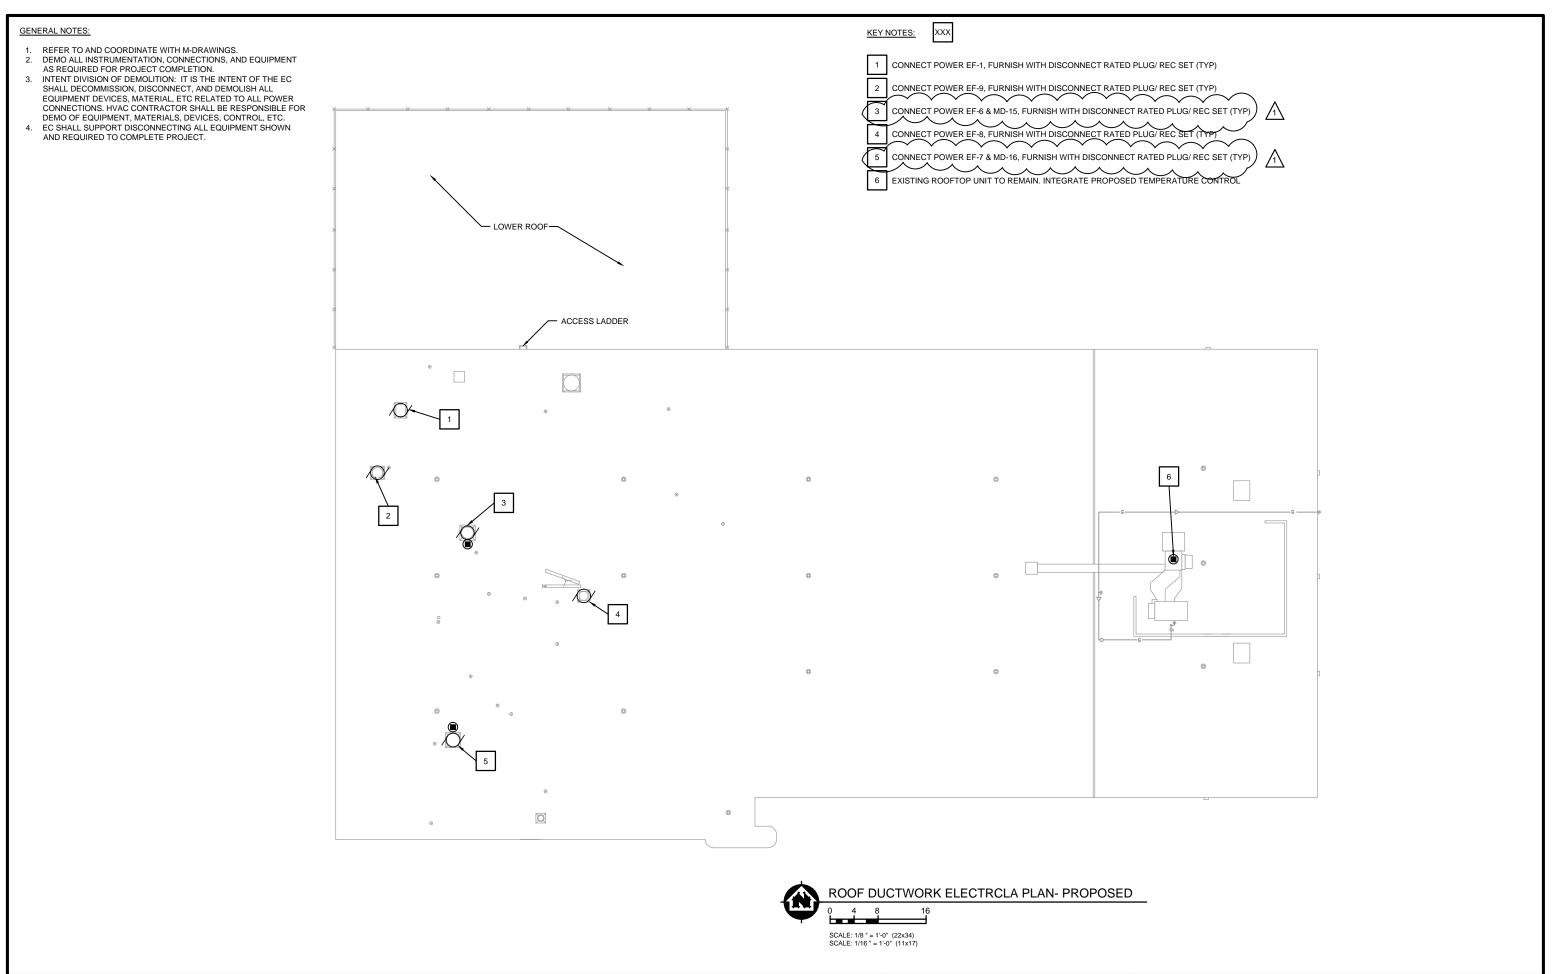


PROJECT NO.:	0061609	SCALE: AS	SHOWN	NO. DAT	ΓE	REVISION	BY	I HEREBY CERTIFY THAT THIS PLAN, REPORT, OR SPECIFICATIO	ON WAS PREPARED BY ME (	OR UNDER MY DIRECT		TRANSPORTATION - MUNICIPAL	LAKEWOOD WITH HIVAC SYSTEM IMPROVEMENTS	DOOF DUOTOWDY	FILE NO.
PROJECT DATE:	MARCH 2016	DRAWN BY	INIT	1 3/2	5	ADDENDUM #1		SUPERVISION AND THAT I AM A DULY LICENSED PROFESSIONAL	L ENGINEER UNDER THE L/	AWS OF THE STATE OF MINNESOTA.	MSA	DEVELOPMENT - ENVIRONMENTAL	EAREWOOD WIT TIVAC STOTEM IN ROVEMENTS	ROOF DUCTOWRK	00616097
F.B. :		CHECKED	Y: SRC					C# RPLI-	MARCH 25, 2016	44007		332 W. Superior Street Duluth, MN 55802	CITY OF DULUTH		
								SCOTT R. CHILSON	Doto	Ligana No		218-722-3915 1-800-777-7380 Fax: 218-722-4548 Web Address: www.msa-ps.com		ELECTRICAL PLAN - PROPOSED	SHEET
DLOT DATE: 3/25	5/16 D:\610e\616\0	616007\CADD\(	netruction Doc	umente\ADDI	ENDLIM #	1/616007 E-15P dwg		30011 K. CHILSON	Date	License No.	PROFESSIONAL SERVICE	© MSA Professional Services Inc.	LAKEWOOD, WIN		E-15R

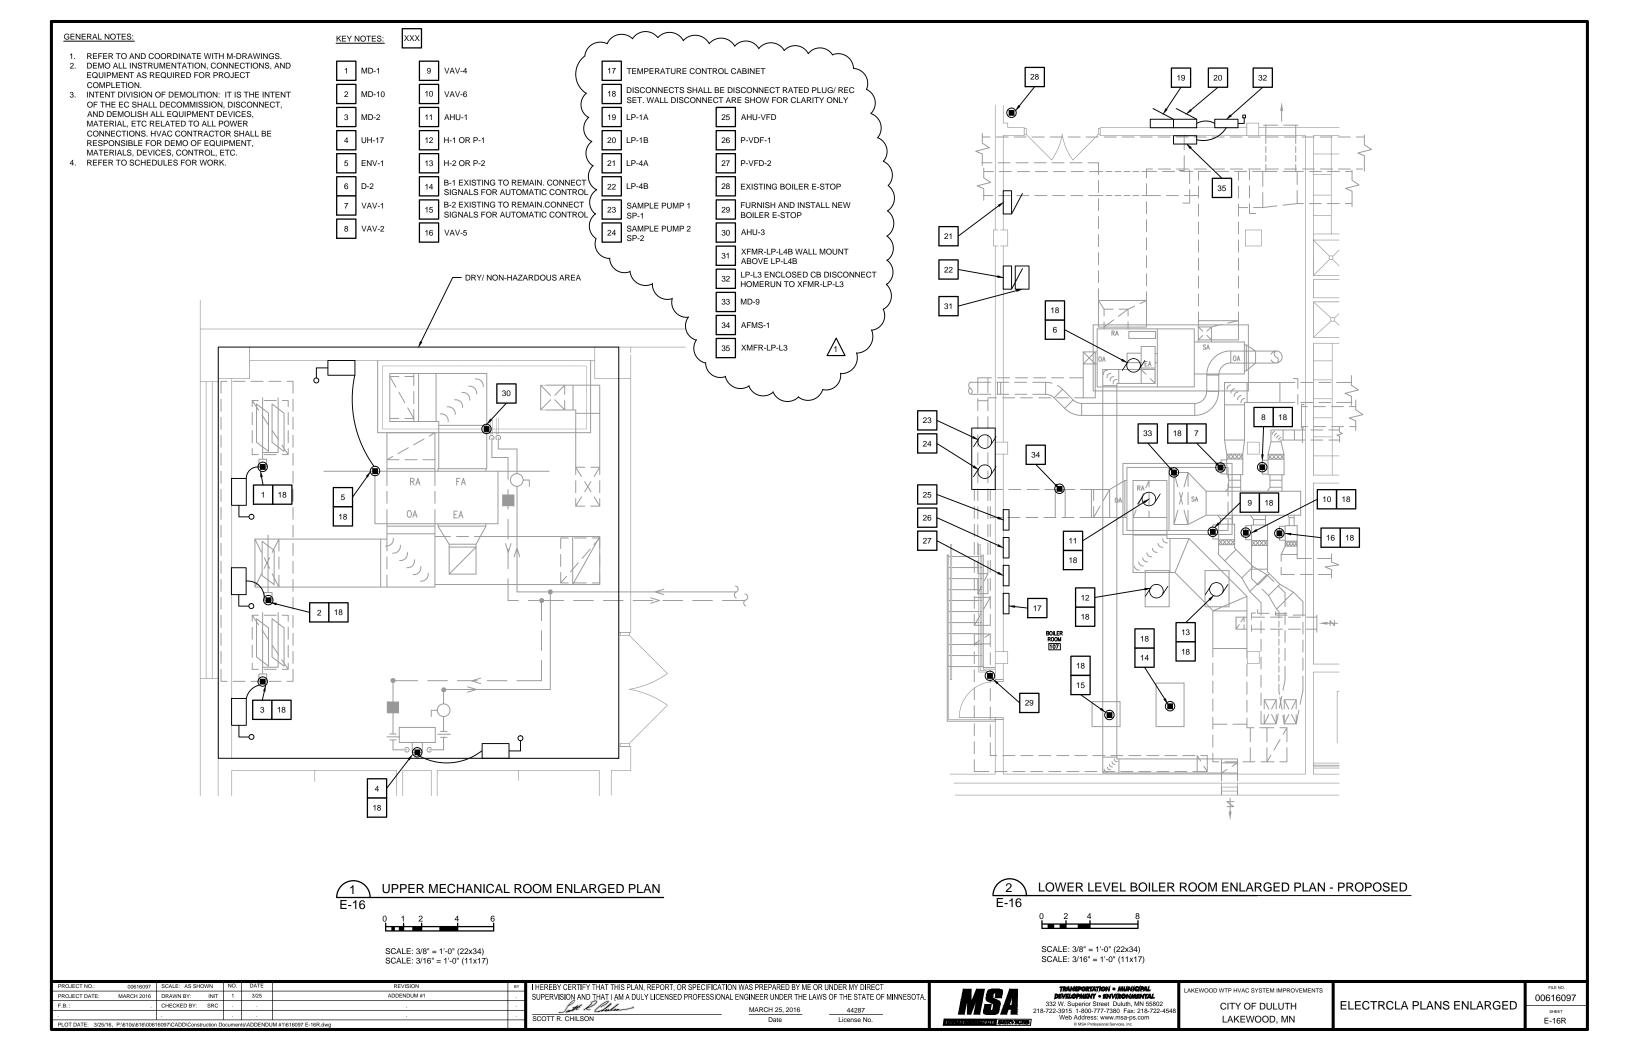

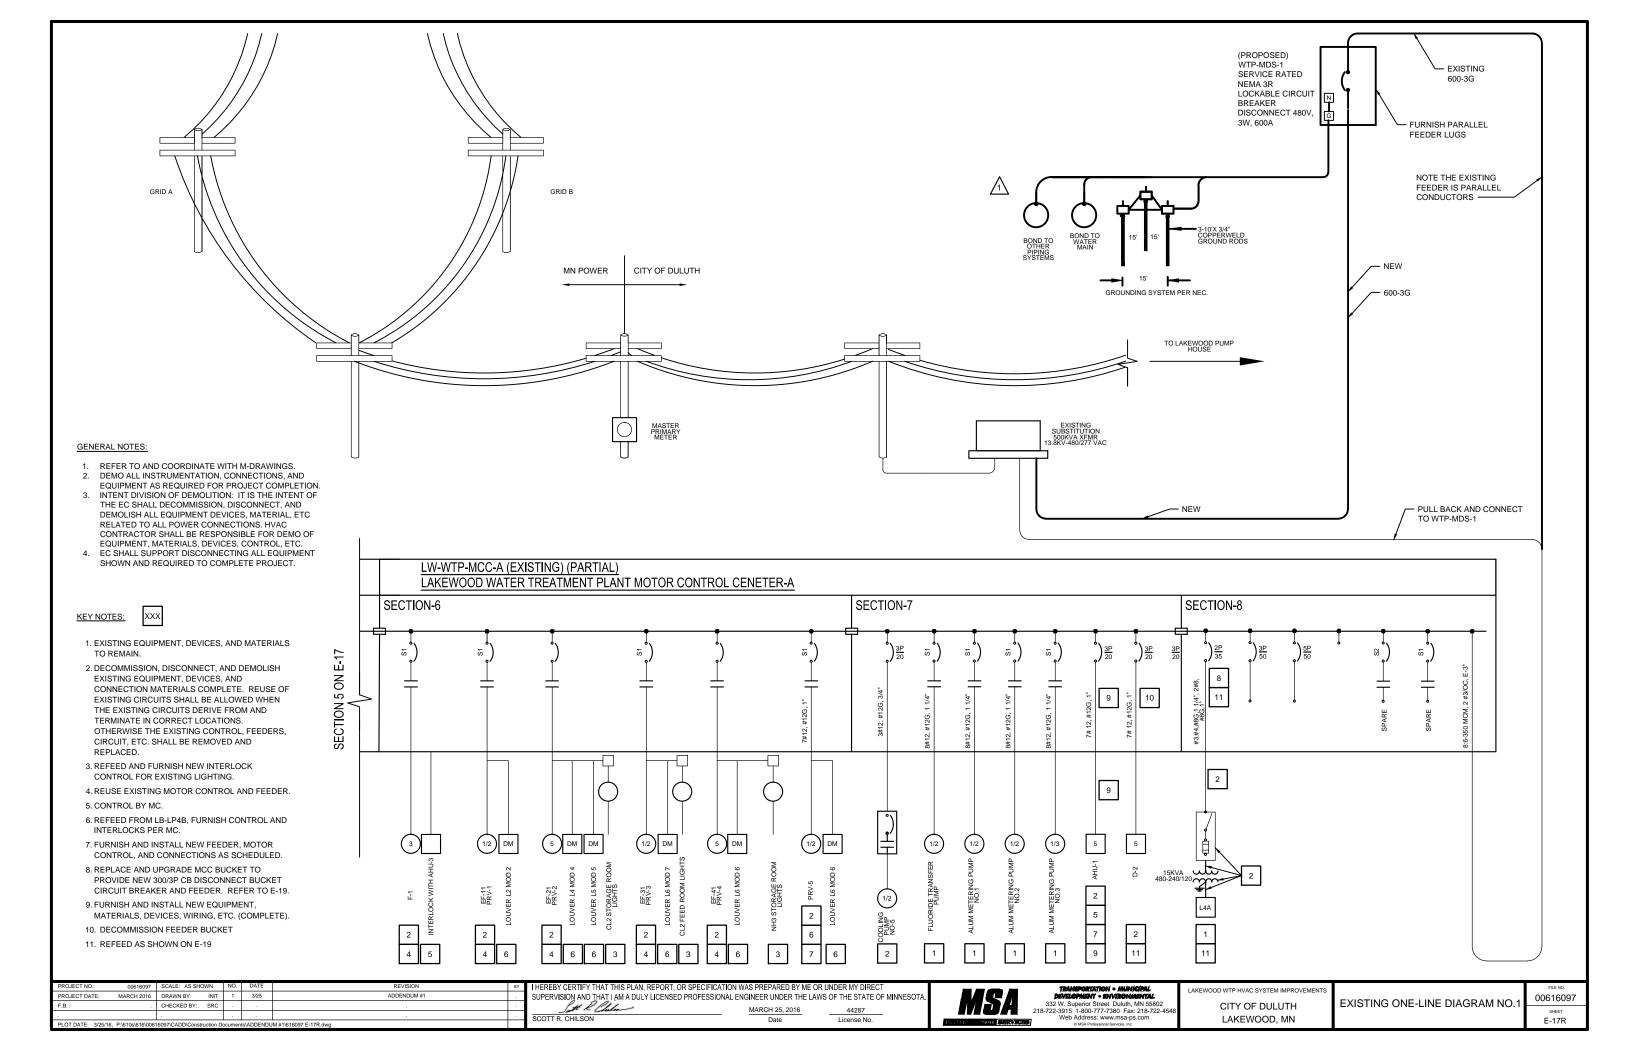

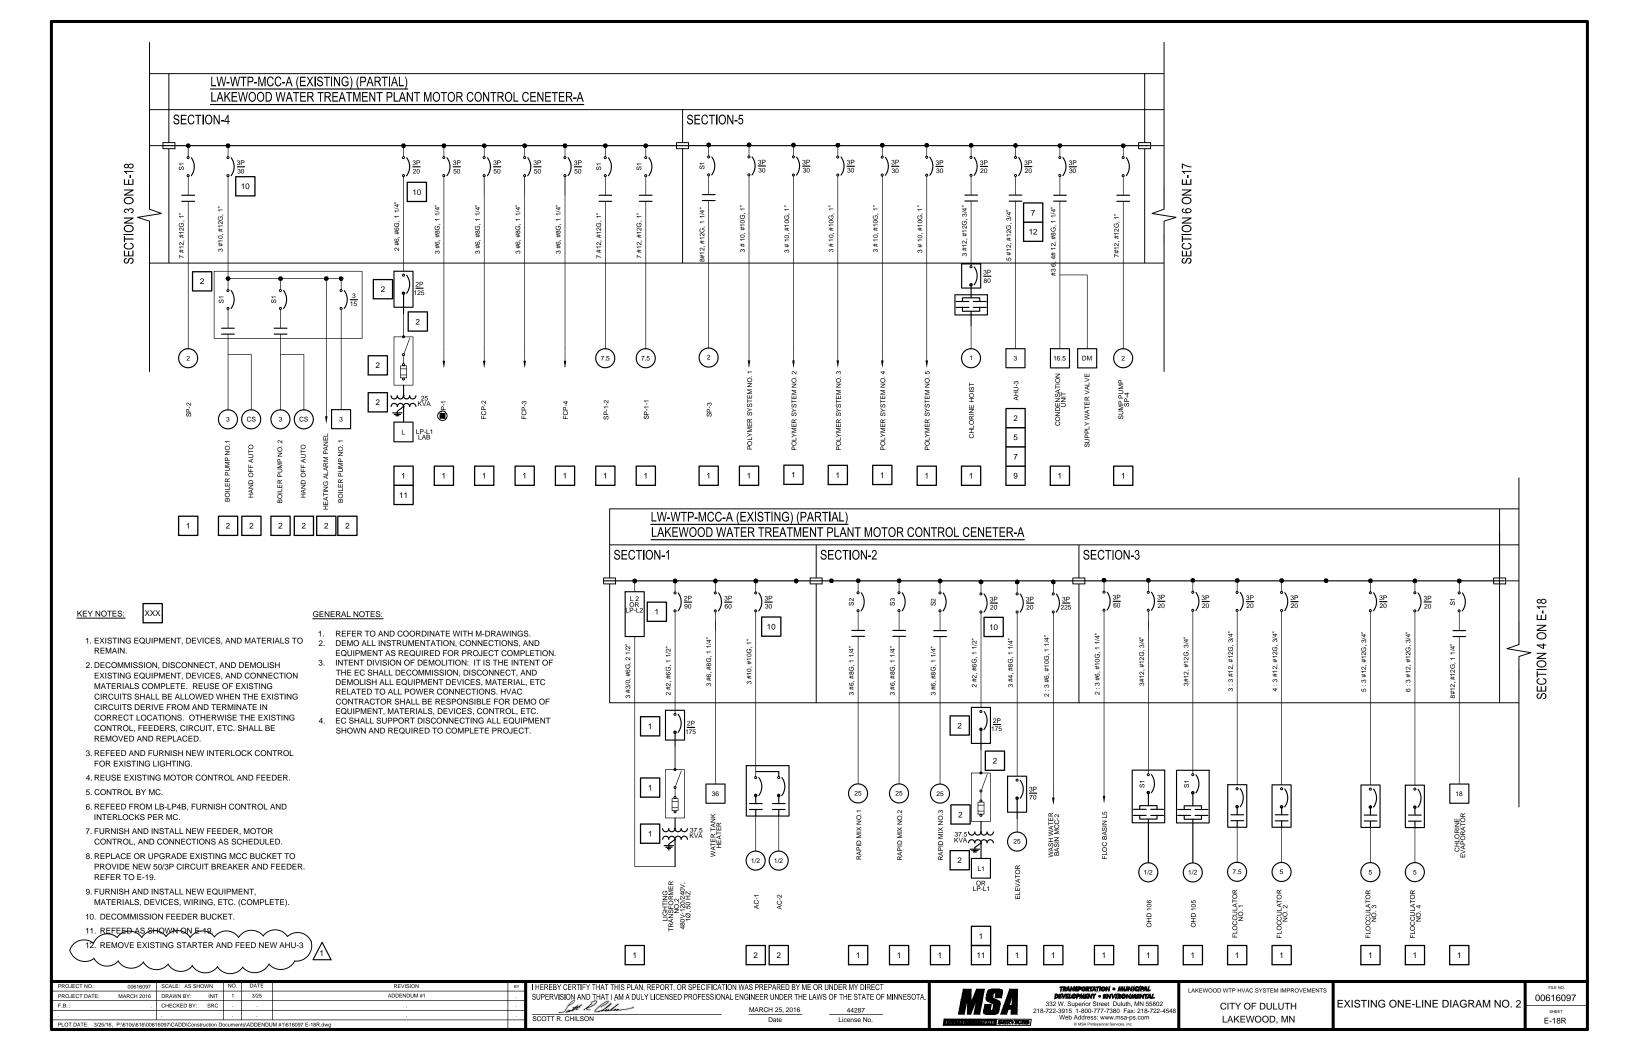

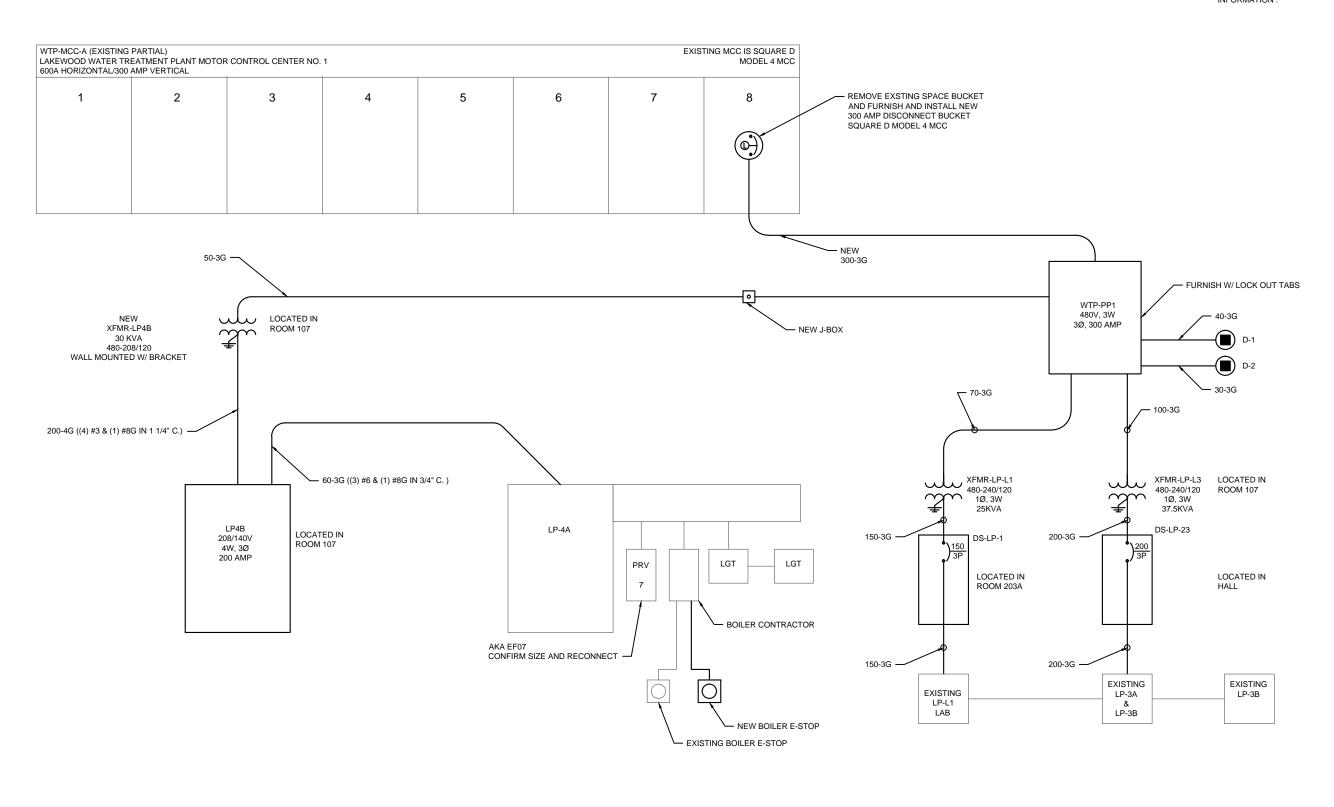

PROJECT NO.:	00616097	SCALE: AS SHOW	VN	NO.	DATE	REVISION	BY	I HEREBY CERTIFY THAT THIS PLAN, REPORT, OR SPECIFICATION	N WAS PREPARED BY ME
PROJECT DATE:	MARCH 2016	DRAWN BY:	INIT	1	3/25	ADDENDUM #1		SUPERVISION AND THAT I AM A DULY LICENSED PROFESSIONAL	L ENGINEER UNDER THE I
F.B. :	-	CHECKED BY:	SRC		٠			Cott & Plate	MARCH 25, 2016
								SCOTT R. CHILSON	Date
PLOT DATE: 3/25/16	P-\610s\616\006	I6097\CADD\Constru	ction D	ocumen	ts\ADDENDL	M #1/616097 F-19R dwg		OOOTT IN. OTHEOON	Date

/ ME OR UNDER MY DIRECT
HE LAWS OF THE STATE OF MINNESOTA.

3 44287
License No.

TRANSPORATION - MUNICIPAL

DEVELOPMENT - ENVIRONMENTAL

332 W. Superior Street Duluth, MN 55802

-722-3915 1-800-777-7380 Fax: 218-722-4548

Web Address: www.msa-ps.com

Okal Professional Services, Inc.

CITY OF DULUTH

LAKEWOOD, MN

ONE-LINE DIAGRAM FOR POWER SUPPLY

FILE NO. 00616097 SHEET E-19R SINGLE PHASE PANEL SCHEDULE PANEL ID/TAG: LP-L2 (EXISITNG) LIGHTING AND APPLIANCE PANEL BUS CONSTRUCTION: CU BUS AMPACITY: 225A (EXISTING TO REMAIN/MODIFY AS REQURIED) OLTAGE WYE /120V GROUND BUS: YES ISOLATED GROUND BUS: YES HASE/WIRE: SUB-FEED LUGS MOUNT SURFACE INTERRUPTING CAPACITY 10 KAIC DESCRIPTION DESCRIPTION LOADS SERVED RM 200 LIGHTS 219,214,215,216 LIGHTS 200,201,202,215,216 LIGHTS 03 211 LIGHT: 203 205 REG 17.216 REC FILTER CONSOL NO.1 FILTER CONSOL NO.2 FILTER CONSOL NO.3 LOADS BY TYPE: 0 0 0 0 :LOADS BY TYPE TOTAL AMPS / PHASE: 0.0 0.0 TOTAL LOADS BY TYPE: 0 0 0 0 TOTAL CONNECTED KVA: 0.0 KVA / PHASE:

### GENERAL PANEL CONSTRUCTION NOTES:

- ALL WORK BY THIS CONTRACTOR TO COMPLY WITH ALL LOCAL, STATE AND NATIONAL ELECTRICAL CODES.
  THIS CONTRACTOR SHALL BE RESPONSIBLE FOR COORDINATION WITH OTHER TRADES TO AVOID CONFLICTS AND TO VERIFYALL EQUIPMENT CONNECTION REQUIREMENTS.
- THIS CONTRACTOR SHALL BE RESPONSIBLE FOR INSTALLING A COMPLETE ELECTRICAL SYSTEMPER CONTRACT DOCUMENTS AND ENSURING THAT THE SYSTEM IS OPERATIONAL UPON JOB COMPLETION. THIS CONTRACTOR SHALL BE RESPONSIBLE FOR INSTALLING A COMPLETE ELECTRICAL SYSTEM FOR ALL OWNER-FURNISHED APPLIANCES IN ACCORDANCE WITH NEC ARTICLE 422 AND 440 22.
- THE ELECTRICAL CONTRACTOR SHALL FURNISH AND INSTALL ALL BRANCH CIRCUIT WRING IN ACCORDANCE WITH NATIONAL ELECTRICAL CODE AND THESE PROJECT DOCUMENTS
- PROVIDE ALL POWER WIRING INCLUDING ALL CIRCUITRY CARRYING ELECTRICAL ENERGY FROMPANELBOARD OR OTHER SOURCE THROUGH STARTERS AND DISCONNECTS TO MOTORS, PACKAGED EQUIPMENT, OR PACKAGED CONTROL PANELS, PROVIDE ALL WIRING BETWEEN CONTROL PANELS AND MOTORS.
- MOTORS CONNECTED TO EMERGENCY SYSTEMS CIRCUITRY SHALL HAVE CIRCUITRY INSTALLED IN SEPARATE RACEWAY PER NEC ARTICLE 700
- PROVIDE SEPARATE GREEN GROUND FOR EACH MOTOR AND EQUIPMENT CONNECTION ROUTED BACKTO INTEGRAL GROUND BUS OF ASSOCIATED PANELBOARD OR MOTOR CONTROL CENTER. GROUND CONDUCTOR
- ALL HEATING, AIR CONDITIONING AND REFRIGERATION EQUIPMENT INSTALLED ON THE EXTERIOR OF THE BUILDING OR ROOF TOP SHALL HAVE A15 AMP, 125V MEATHER-RESISTANT GFCI RECEPTACLE SURFACE
- THIS CONTRACTOR SHALL VERIFY ELECTRICAL REQUIREMENTS INCLUDING VOLTAGE, HORSEPOWER, STARTER TYPE, AND DISCONNECTING MEANS FOR MOTORS AND EQUIPMENT PRIOR TO ORDERING CIRCUIT
- 1. REFER TO ONE-LINE AND P&ID'S FOR ADDITIONAL INFORMATION AND DETIAL.
- 12. REFER TO FEEDER SCHEUDLE FOR ADDITIONAL INFORMATION AND DETIAL

### PANEL NOTES:

	SING	LE PHA	ASE PA	NEL SC	HEDUL	E		PANEL	ID/TAG		LP-L4	A (EXI	STI	√G)								
7	YPE					APPLIANCE PANEL REMAIN/MODIFY AS REQURIED)			BU	IS C	ONSTRU	JCTION:	CU				BUS AMPACITY:				NA	
		AGE:		240			8/120)				GROUN	D BUS:	YES	3			MAIN CIRCUIT BRI	EAKER:			NONE	
		SE/WIR	E:	1P-3W					ISOLA	TED	GROUN	D BUS:	YES	3			SUB-FEED LUGS:				YES	
1	MOU!	NT:		SURFA	CE												INTERRUPTING CA	APACITY	<b>'</b> :		10 KAI	0
ı		L	OADS	SERVE	)	DESCRIPTION	LOAD	BKR	BKR		Α	В		BKR	BKR	LOAD	DESCRIPTION		LOADS	SERVE	)	
		LGT	REC.	MECH.			AMP	SIZE	POLE		AMP	AMP		POLE	SIZE	AMP		LGT	REC.	MECH.	OTHER	
	1					#4 ZONE HEATERS (*)	4	20	1	1	6.0	***	2	1	20	2	LOWER GALLERY REC					2
	3					#3 ZONE HEATERS (*)	4	20	1	3	size 6	6.0	4	1	20	2	LOWER GALLERY LIGHTS					4
	5					LIGHTS FILTER NO.5	4	20	1	5	8.0	为专案	6	1	20	4	LOWER GALLERY UNIT HEATERS (*)					6
	7					2ND FLOOR GALLERY LIGHTS	2	20	1	7	feet/sk	3.0	8	1	20		STAIRS LIGHTS					8
	9					LIGHTS 2ND FLOOR GALLERY	2	20	1	9	5.0	Ark m	10	1	20		2ND FLOOR GALLERY REC					10
	11					SPARE		20	1	11	#39KB	2.0	12	1	20		FILTER NO.6 LIGHTS					12
	13					SPARE		20	1	13	4.0	《宋書·	14	1	20		#2 ZONE HEATERS (*)					14
	15					SPARE		20	2	15	plays.	4.0	16	1	20		#1 ZONE HEATERS (*)					16
	17							1	2	17	0.0	***	18	2	20		SPARE					18
	19					SPACE				19	feet in	12.0	20	2	20		ENTRY GATE					20
	21					SPACE				21	12.0	Arks.	22	2	1	12						22
	23					SPACE				23	N-9E-M	0.0	24				SPACE					24
	25					SPACE				25	0.0	et as	26				SPACE					26
	27					SPACE				27	RONE	0.0	28				SPACE					28
	29					SPACE				29	0.0	***	30				SPACE					30
	31					SPACE				31	Alberta.	0.0	32				SPACE					32
	33					SPACE				33	0.0	为专案	34				SPACE					34
	35					SPACE				35	k With	0.0	36				SPACE					36
	37					SPACE				37	0.0	268	38				SPACE					38
	39					SPACE	_			39	ASH R	0.0	40				SPACE					40
L	41					SPACE				41	0.0	«xs	42				SPACE					42
	L	0	0	0	0	:LOADS BY TYPE											LOADS BY TYPE:	0	0	0	0	
						TOTAL	AMPS/I	PHASE:			35.0	27.0	_				TOTAL LOADS BY TYPE:	0	0	0	0	
							KVA / I	PHASE:			4.9	3.7					TOTAL CONNECTED KVA	8.6				

- ALL WORK BY THIS CONTRACTOR TO COMPLY WITH ALL LOCAL STATE AND NATIONAL ELECTRICAL CODES
- THIS CONTRACTOR SHALL BE RESPONSIBLE FOR COORDINATION WITH OTHER TRADES TO AVOID CONFLICTS AND TO VERIFY ALL EQUIPMENT CONNECTION REQUIREMENTS.

  THIS CONTRACTOR SHALL BE RESPONSIBLE FOR COORDINATION WITH OTHER TRADES TO AVOID CONFLICTS AND TO VERIFY ALL EQUIPMENT CONNECTION REQUIREMENTS.

  THIS CONTRACTOR SHALL BE RESPONSIBLE FOR INSTALLING A COMPLETE ELECTRICAL SYSTEM PER CONTRACT DOCUMENTS AND ENSURING THAT THE SYSTEM IS OPERATIONAL UPON JOB COMPLETION.
- THIS CONTRACTOR SHALL BE RESPONSIBLE FOR INSTALLING A COMPLETE ELECTRICAL SYSTEM FOR ALL OWNER-FURNISHED APPLIANCES IN ACCORDANCE WITH NEC ARTICLE 422 AND 440.22. THE ELECTRICAL CONTRACTOR SHALL FURNISH AND INSTALL ALL BRANCH CIRCUIT WIRING IN ACCORDANCE WITH NATIONAL ELECTRICAL CODE AND THESE PROJECT DOCUMENTS
- PROVIDE ALL POWER WIRING INCLUDING ALL CIRCUITRY CARRYING ELECTRICAL ENERGY FROM PANELBOARD OR OTHER SOURCE THROUGH STARTERS AND DISCONNECTS TO MOTORS, PACKAGED EQUIPMENT, OR PACKAGED CONTROL PANELS. PROVIDE ALL WIRING BETWEEN CONTROL PANELS AND MOTORS. I
- MOTORS CONNECTED TO EMERGENCY SYSTEMS CIRCUITRY SHALL HAVE CIRCUITRY INSTALLED IN SEPARATE RACEWAY PER NEC ARTICLE 700. PROVIDE SEPARATE GREEN GROUND FOR EACH MOTOR AND EQUIPMENT CONNECTION ROUTED BACK TO INTEGRAL GROUND BUS OF ASSOCIATED PANELBOARD OR MOTOR CONTROL CENTER. GROUND CONDUCTOR

ADDENDUM #1

- SIZES PER NEC ARTICLE 250, 122. ALL HEATING, AIR CONDITIONING AND REFRIGERATION EQUIPMENT INSTALLED ON THE EXTERIOR OF THE BUILDING OR ROOF TOP SHALL HAVE A 15 AMP, 125V WEATHER-RESISTANT GFCI RECEPTACLE SURFACE
- MOUNTED IN WEATHERPROOF ENCLOSURE, MOUNTED ADJACENT TO EQUIPMENT. THIS CONTRACTOR SHALL VERIFY ELECTRICAL REQUIREMENTS INCLUDING VOLTAGE, HORSEPOWER, STARTER TYPE, AND DISCONNECTING MEANS FOR MOTORS AND EQUIPMENT PRIOR TO ORDERING CIRCUIT
- BREAKERS, DISCONNECT SWITCHES, AND STARTERS
- REFER TO ONE-LINE AND P&ID'S FOR ADDITIONAL INFORMATION AND DETIAL
   REFER TO FEEDER SCHEUDLE FOR ADDITIONAL INFORMATION AND DETIAL.

SRC

- DEMOLISH AND CONNECT NEW
- CONFIRM CONNECTION

3Y	I HEREBY CERTIFY THAT THIS PLAN, REPORT, OR SPECIFICA	TION WAS PREPARED BY ME O	R UNDER MY DIRECT	
	SUPERVISION AND THAT I AM A DULY LICENSED PROFESSION	NAL ENGINEER UNDER THE LAY	NS OF THE STATE OF M	MINNESOTA.
	Latt & Clalin	MARCH 25, 2016	44287	
	SCOTT R. CHILSON	Date	License No.	

NAL CHAPTES



AKEWOOD WTP HVAC SYSTEM IMPROVEMENT CITY OF DULUTH LAKEWOOD, MN

ELECTRICAL SCHEDULES NO.

00616097 E-22R

225A

NONE

10 KAIC

LOADS SERVED

MAIN CIRCUIT BREAKER:

INTERRUPTING CAPACITY

SUB-FEED LUGS

TOTAL LOADS BY TYPE: 0

TOTAL CONNECTED KVA: 0.0

DESCRIPTION

112, 114, 115 LIGHTS

7 LIGHTS 3. 112. 111 LIGHTS

102 104 105 106 RE

SIGN

THREE PHASE PANEL SCHEDULE PANEL ID/TAG: LP-L4B (PROPOSED) BUS CONSTRUCTION: PANELBOARD BUS AMPACITY VOLTAGE: 208 WYE /120V GROUND BUS MAIN CIRCUIT BREAKER 100A SUB-FEED LUGS: INTERRUPTING CAPACITY 10 KAIC LOADS SERVED LOADS SERVED DESCRIPTION DESCRIPTION 5.8 20 4.4 20 7.8 20 10.4 SPARE SPARE 2.4 2.4 20 1 LOADS BY TYPE: 0 0 88 0

TOTAL LOADS BY TYPE: 0 0 179 62 TOTAL AMPS / PHASE 80.8 79.0 78.1 KVA / PHASE: 9.7 9.5 9.4 TOTAL CONNECTED KVA: 28.6

THIS CONTRACTOR SHALL BE RESPONSIBLE FOR COORDINATION WITH OTHER TRADES TO AVOID CONFLICTS AND TO VERIFY ALL EQUIPMENT CONNECTION REQUIREMENTS.
THIS CONTRACTOR SHALL BE RESPONSIBLE FOR INSTALLING A COMPLETE ELECTRICAL SYSTEM PER CONTRACT DOCUMENTS AND ENSURING THAT THE SYSTEM IS OPERATIONAL UPON JOB COMPLETION. THIS CONTRACTOR SHALL BE RESPONSIBLE FOR INSTALLING A COMPLETE ELECTRICAL SYSTEM FOR ALL OWNER-FURNISHED APPLIANCES IN ACCORDANCE WITH NEC ARTICLE 422 AND 440.22. THE ELECTRICAL CONTRACTOR SHALL FURNISH AND INSTALL ALL BRANCH CIRCUIT WIRING IN ACCORDANCE WITH NATIONAL ELECTRICAL CODE AND THESE PROJECT DOCUMENTS PROVIDE ALL POWER WIRING INCLUDING ALL CIRCUITRY CARRYING ELECTRICAL ENERGY FROM PANELBOARD OR OTHER SOURCE THROUGH STARTERS AND DISCONNECTS TO MOTORS, PACKAGED EQUIPMENT, OR PACKAGED CONTROL PANELS. PROVIDE ALL WIRING BETWEEN CONTROL PANELS AND MOTORS. I MOTORS CONNECTED TO EMERGENCY SYSTEMS CIRCUITRY SHALL HAVE CIRCUITRY INSTALLED IN SEPARATE RACEWAY PER NEC ARTICLE 700. PROVIDE SEPARATE GREEN GROUND FOR EACH MOTOR AND EQUIPMENT CONNECTION ROUTED BACK TO INTEGRAL GROUND BUS OF ASSOCIATED PANELBOARD OR MOTOR CONTROL CENTER, GROUND CONDUCTOR SIZE PER NEC ARTICLE 250.122. ALL HEATING, AIR CONDITIONING AND REFRIGERATION EQUIPMENT INSTALLED ON THE EXTERIOR OF THE BUILDING OR ROOF TOP SHALL HAVE A 15 AMP, 125V WEATHER-RESISTANT GFCI RECEPTACLE SURFACE MOUNTED IN WEATHERPROOF ENCLOSURE, MOUNTED ADJACENT TO EQUIPMENT. THIS CONTRACTOR SHALL VERIFY ELECTRICAL REQUIREMENTS INCLUDING VOLTAGE, HORSEPOWER, STARTER TYPE, AND DISCONNECTING MEANS FOR MOTORS AND EQUIPMENT PRIOR TO ORDERING CIRCUIT BREAKERS,

0.0 0.0

0.0 0.0

PANEL ID/TAG: LP-3A (EXISTING)

LOAD BKR BKR

TOTAL AMPS / PHASE:

KVA / PHASE:

BUS CONSTRUCTION: CU

ISOLATED GROUND BUS: YES

BKR BKR LOAD

DISCONNECT SWITCHES, AND STARTERS 11. REFER TO ONE-LINE AND P&ID'S FOR ADDITIONAL INFORMATION AND DETIAL

12. REFER TO FEEDER SCHEUDLE FOR ADDITIONAL INFORMATION AND DETIAL.

DEMOLISH AND CONNECT NEW CONFIRM CONNECTION

SINGLE PHASE PANEL SCHEDULE

LOADS SERVED

/OLTAGE

MOUNT:

LIGHTING AND APPLIANCE PANEL

240 WYE /120V

SURFACE

(EXISTING TO REMAIN/MODIFY AS REQURIED)

DESCRIPTION

101, 102, 114, 116, 118 LIGHTS

119 AND MAIN DOOR LIGHTS

107 & HOT WATER HEATER (\*\*)
CONTROL POWER AIR CONDITIONER (

ALL WORK BY THIS CONTRACTOR TO COMPLY WITH ALL LOCAL STATE AND NATIONAL ELECTRICAL CODES.

102, 109, 101 LIGHTS

101 AND MAIN DOOR RE

108 LIGHTS

WALKWAY 7

1. ALL WORK BY THIS CONTRACTOR TO COMPLY WITH ALL LOCAL, STATE AND NATIONAL ELECTRICAL CODES.

- THIS CONTRACTOR SHALL BE RESPONSIBLE FOR COORDINATION WITH OTHER TRADES TO AVOID CONFLICTS AND TO VERIFY ALL EQUIPMENT CONNECTION REQUIREMENTS.
  THIS CONTRACTOR SHALL BE RESPONSIBLE FOR INSTALLING A COMPLETE ELECTRICAL SYSTEM PER CONTRACT DOCUMENTS AND ENSURING THAT THE SYSTEM IS OPERATIONAL UPON JOB COMPLETION.
- F. THIS CONTRACTOR SHALL BE RESPONSIBLE FOR INSTALLING A COMPLETE ELECTRICAL SYSTEM FOR ALL OWNER-FURNISHED APPLIANCES IN ACCORDANCE WITH NEC ARTICLE 422 AND 440,22.
- THE ELECTRICAL CONTRACTOR SHALL FURNISH AND INSTALL ALL BRANCH CIRCUIT WIRING IN ACCORDANCE WITH NATIONAL ELECTRICAL CODE AND THESE PROJECT DOCUMENTS
- PROVIDE ALL POWER WIRING INCLUDING ALL CIRCUITRY CARRYING ELECTRICAL ENERGY FROM PANELBOARD OR OTHER SOURCE THROUGH STARTERS AND DISCONNECTS TO MOTORS, PACKAGED EQUIPMENT, OR PACKAGED
- MOTORS CONNECTED TO EMERGENCY SYSTEMS CIRCUITRY SHALL HAVE CIRCUITRY INSTALLED IN SEPARATE RACEWAY PER NEC ARTICLE 700.
- PROVIDE SEPARATE GREEN GROUND FOR EACH MOTOR AND EQUIPMENT CONNECTION ROUTED BACK TO INTEGRAL GROUND BUS OF ASSOCIATED PANELBOARD OR MOTOR CONTROL CENTER. GROUND CONDUCTOR SIZES PER NEC ARTICLE 250.122. ALL HEATING, AIR CONDITIONING AND REFRIGERATION EQUIPMENT INSTALLED ON THE EXTERIOR OF THE BUILDING OR ROOF TOP SHALL HAVE A 15 AMP, 125V WEATHER-RESISTANT GFCI RECEPTACLE SURFACE MOUNTED IN
- WEATHER PROOF ENCLOSURE, MOUNTED ADJACENT TO EQUIPMENT. THIS CONTRACTOR SHALL VERIFY ELECTRICAL REQUIREMENTS INCLUDING VOLTAGE, HORSEPOWER, STARTER TYPE, AND DISCONNECTING MEANS FOR MOTORS AND EQUIPMENT PRIOR TO ORDERING CIRCUIT BREAKERS,
- DISCONNECT SWITCHES, AND STARTERS
- 11. REFER TO ONE-LINE AND PAID'S FOR ADDITIONAL INFORMATION AND DETIAL 12. REFER TO FEEDER SCHEUDLE FOR ADDITIONAL INFORMATION AND DETIAL.

PANEL NOTES:

\* FURHISH 24 DC TRANSFORMER TO CONNECT

SINGLE PHASE PANEL SCHEDULE PANEL ID/TAG: LP-L1 LAB (EXISITNG) LIGHTING AND APPLIANCE PANEL BUS CONSTRUCTION: CU BUS AMPACITY 225A (EXISTING TO REMAIN/MODIFY AS REQURIED) VOLTAGE GROUND BUS: YES MAIN CIRCUIT BREAKER NONE 240 WYE /120V SUB-FEED LUGS: INTERRUPTING CAPACITY PHASE/WIRE: ISOLATED GROUND BUS: YES SURFACE 10 KAIC LOADS SERVED LOADS SERVED DESCRIPTION DESCRIPTION LGT LGT REC. MECH. OTHER EC AND FUME HOOD 106 208 RFC 208 AND 209 REC 220V REC ON WEST WALL 209 REC 208 AND 209 REG 209 AND 213 REG REFERIGERATOR 20 REFERIGERATOR 209 220V REC ON WEST WALL SPACE SPACE SPACE 0 :LOADS BY TYPE LOADS BY TYPE TOTAL AMPS / PHASE: 0.0 0.0 KVA / PHASE: 0.0 0.0 TOTAL CONNECTED KVA: 0.0

- ALL WORK BY THIS CONTRACTOR TO COMPLY WITH ALL LOCAL, STATE AND NATIONAL ELECTRICAL CODES.
- THIS CONTRACTOR SHALL BE RESPONSIBLE FOR COORDINATION WITH OTHER TRADES TO AVOID CONFLICTS AND TO VERIFY ALL EQUIPMENT CONNECTION REQUIREMENTS.
- THIS CONTRACTOR SHALL BE RESPONSIBLE FOR INSTALLING A COMPLETE ELECTRICAL SYSTEM PER CONTRACT DOCUMENTS AND ENSURING THAT THE SYSTEM IS OPERATIONAL UPON JOB COMPLETION THIS CONTRACTOR SHALL BE RESPONSIBLE FOR INSTALLING A COMPLETE ELECTRICAL SYSTEM FOR ALL OWNER-FURNISHED APPLIANCES IN ACCORDANCE WITH NEC ARTICLE 422 AND 440.22.
- 5. THE ELECTRICAL CONTRACTOR SHALL FURNISH AND INSTALL ALL BRANCH CIRCUIT WIRING IN ACCORDANCE WITH NATIONAL ELECTRICAL CODE AND THESE PROJECT DOCUMENTS
- PROVIDE ALL POWER WIRING INCLUDING ALL CIRCUITRY CARRYING ELECTRICAL ENERGY FROM PANELBOARD OR OTHER SOURCE THROUGH STARTERS AND DISCONNECTS TO MOTORS, PACKAGED EQUIPMENT, OR PACKAGED CONTROL PANELS. PROVIDE ALL WIRING BETWEEN CONTROL PANELS AND MOTORS. I
- MOTORS CONNECTED TO EMERGENCY SYSTEMS CIRCUITRY SHALL HAVE CIRCUITRY INSTALLED IN SEPARATE RACEWAY PER NEC ARTICLE 700.
- PROVIDE SEPARATE GREEN GROUND FOR EACH MOTOR AND EQUIPMENT CONNECTION ROUTED BACK TO INTEGRAL GROUND BUS OF ASSOCIATED PANELBOARD OR MOTOR CONTROL CENTER. GROUND CONDUCTOR
- ALL HEATING, AIR CONDITIONING AND REFRIGERATION EQUIPMENT INSTALLED ON THE EXTERIOR OF THE BUILDING OR ROOF TOP SHALL HAVE A 15 AMP, 125V WEATHER-RESISTANT GFCI RECEPTACLE SURFACE MOUNTED IN WEATHERPROOF ENCLOSURE, MOUNTED ADJACENT TO EQUIPMENT.
- THIS CONTRACTOR SHALL VERIFY ELECTRICAL REQUIREMENTS INCLUDING VOLTAGE, HORSEPOWER, STARTER TYPE, AND DISCONNECTING MEANS FOR MOTORS AND EQUIPMENT PRIOR TO ORDERING CIRCUIT BREAKERS, DISCONNECT SWITCHES, AND STARTERS

DRAWN BY:

INIT

3/25

- I. REFER TO ONE-LINE AND P&ID'S FOR ADDITIONAL INFORMATION AND DETIAL 12. REFER TO FEEDER SCHEUDLE FOR ADDITIONAL INFORMATION AND DETIAL

### PANEL NOTES:

		J	FINISH/PAINT SCHEDULI	E											
COORDINATE SCHEDUL	E WITH SPECIFICATION A	AND OTHER DISCIPLINES													
ASSUME PAINT IS NOT	REQUIRED IS ROOMS NO	T IDENTIFIED IN THE SCH	HEDULE OR SPECIFICALLY	REQURIED IN SPECIFICA	TION OR DRAWINGS										
LOCATION															
EXTERIOR D-1 FACTORY NO FACTORY YES YES  FANS FACTORY NO NO NO NO NO															
FANS FACTORY NO NO NO NO															
MDS FACTORY NO NO NO NO															
INTERIOR NO NO NO NO NO															
	100	FACTORY	NO	YES	YES	YES									
	100 STAIR WELL	FACTORY	YES	YES	YES	YES									
	107	FACTORY	YES	YES	YES	YES									
	108	FACTORY	EAST WALL ONLY	YES	YES	YES									
	109	FACTORY	YES	YES	YES	YES									
	110	NO	SW CORNER ONLY	NO	NO	NO									
	217	FACTORY	YES	YES	YES	YES									
	203	FACTORY	NW WALL ONLY	NO	NO	YES									

ADDENDUM #

THREE PHASE PANEL SCHEDULE PANEL ID/TAG: BE DEMOLISHED) BUS CONSTRUCTION: BUS AMPACITY (EXISTING TO REMOVE) VOLTAGE: 480 WYE /277V GROUND BUS MAIN CIRCUIT BREAKER: 200A SUB-FEED LUGS: INTERRUPTING CAPACITY ISOLATED GROUND BUS: MOUNT: SURFACE DESCRIPTION LOADS SERVED LOADS SERVED DESCRIPTION LGT REC. MECH. OTHER 3 200 FILTER #1 EFFLUENT VALVE 3 30 FILTER #2 EFFLUENT VALVE FILTER #2 EFFLUENT VALVE 3 30 FILTER #4 EFFLUENT VALVE 3 30 30 SPARE 30 3 SPARE 3 30 WASHWATER SUPPLY VALVE SPARE SPARE 3 30 BATTERY CHARGER 0 0 :LOADS BY TYPE LOADS BY TYPE: TOTAL AMPS / PHASE: 0.0 0.0 0.0 TOTAL LOADS BY TYPE: 0 0 0 0 KVA / PHASE: TOTAL CONNECTED KVA: 0.0 0.0 0.0 0.0 GENERAL PANEL CONSTRUCTION NOTES: ALL WORK BY THIS CONTRACTOR TO COMPLY WITH ALL LOCAL, STATE AND NATIONAL ELECTRICAL CODES THIS CONTRACTOR SHALL BE RESPONSIBLE FOR COORDINATION WITH OTHER TRADES TO AVOID CONFLICTS AND TO VERIFY ALL EQUIPMENT CONNECTION REQUIREMENTS. THIS CONTRACTOR SHALL BE RESPONSIBLE FOR INSTALLING A COMPLETE ELECTRICAL SYSTEM PER CONTRACT DOCUMENTS AND ENSURING THAT THE SYSTEM IS OPERATIONAL UPON JOB COMPLETION.
THIS CONTRACTOR SHALL BE RESPONSIBLE FOR INSTALLING A COMPLETE ELECTRICAL SYSTEM FOR ALL OWNER-FURNISHED APPLIANCES IN ACCORDANCE WITH NEC ARTICLE 422 AND 440 22.

- THE ELECTRICAL CONTRACTOR SHALL FURNISH AND INSTALL ALL BRANCH CIRCUIT WIRING IN ACCORDANCE WITH NATIONAL ELECTRICAL CODE AND THESE PROJECT DOCUMENTS
- PROVIDE ALL POWER WIRING INCLUDING ALL CIRCUITRY CARRYING ELECTRICAL ENERGY FROM PANELBOARD OR OTHER SOURCE THROUGH STARTERS AND DISCONNECTS TO MOTORS, PACKAGED EQUIPMENT, OR PACKAGED CONTRO PANELS. PROVIDE ALL WIRING BETWEEN CONTROL PANELS AND MOTORS. INCLUDE STARTERS, DISCONNECTS, AND OVERLOAD PROTECTION IF NOT INCLUDED IN SPECIFICATIONS. COORDINATE WITH EQUIPMENT SUPPLIER.
- MOTORS CONNECTED TO EMERGENCY SYSTEMS CIRCUITRY SHALL HAVE CIRCUITRY INSTALLED IN SEPARATE RACEWAY PER NEC ARTICLE 700.
- PROVIDE SEPARATE GREEN GROUND FOR EACH MOTOR AND EQUIPMENT CONNECTION ROUTED BACK TO INTEGRAL GROUND BUS OF ASSOCIATED PANELBOARD OR MOTOR CONTROL CENTER. GROUND CONDUCTOR SIZES PER NEC
- ALL HEATING, AIR CONDITIONING AND REFRIGERATION EQUIPMENT INSTALLED ON THE EXTERIOR OF THE BUILDING OR ROOF TOP SHALL HAVE A 15 AMP, 125V WEATHER-RESISTANT GFCI RECEPTACLE SURFACE MOUNTED IN WEATHER PROOF ENCLOSURE, MOUNTED ADJACENT TO EQUIPMENT.
- THIS CONTRACTOR SHALL VERIFY ELECTRICAL REQUIREMENTS INCLUDING VOLTAGE, HORSEPOWER, STARTER TYPE, AND DISCONNECTING MEANS FOR MOTORS AND EQUIPMENT PRIOR TO ORDERING CIRCUIT BREAKERS, DISCONNECT SWITCHES, AND STARTERS
- . REFER TO ONE-LINE AND P&ID'S FOR ADDITIONAL INFORMATION AND DETIAL
- 12. REFER TO FEEDER SCHEUDLE FOR ADDITIONAL INFORMATION AND DETIAL

### PANEL NOTES:

THREE PHASE PANEL SCHEDULE PANEL ID/TAG: PP-1 (PROPOSED) BUS CONSTRUCTION: PANELBOARD BUS AMPACITY: YPE: 400A (PROPOSED) OLTAGE: MAIN CIRCUIT BREAKER GROUND BUS PHASE/WIRE: ISOLATED GROUND BUS: YES SUB-FEED LUGS: NONE MOUNT: SURFACE INTERRUPTING CAPACITY: 22 KIAC LOADS SERVED DESCRIPTION LOAD BKR BKR A B C BKR BKR LOAD DESCRIPTION LOADS SERVED

			SEKVEL		DESCRIP HON	LOAD	DIVIN		1	-		_		DIVIN		LOAD	DESCRIF HON	4	LUADS			
	LGT	REC.	MECH.	OTHER		AMP	SIZE	POLE		AMP	AMP	AMP		POLE	SIZE	AMP		LGT	REC.	MECH.	OTHER	
1				36.0		36			1	36.0	***	***	2									7
3				36.0	XFMR-LP-L4B	36	50	3	3	***	36.0	***	4	3	300		MAIN			i '		4
5					(LOCK-OUT TAB)	36			5	***	***	36.0	6									(
7					XFMR-LP-L1	52	70	2	7	82.0	***	***	8			30		1		30.0		1
9					(LOCK-OUT TAB)	52			9	***	82.0	***	10	3	40	30	D-1			30.0		1
11					XFMR-LP-L3	78	100	2	11		A.A.A.	108.0	12			30	(LOCK-OUT TAB)			30.0		1
13				78.0	(LOCK-OUT TAB)	78				100.0	***	kkk	14			22		1		22.0		1
15					SPARE		50	2	15	***	22.0	***	16	3	30	22	D-2			22.0		1
17									17	***		22.0	18			22	(LOCK-OUT TAB)			22.0		1
17 19 21					SPARE		30	2	19		A.A.A.	***	20									2
21									21		0.0	***	22	3	30		SPARE			i '		2
23 25					SPARE		20	2	23	444	***	0.0	24									2
25									25			***	26							1		2
27					SPARE		30	3	27		0.0	222	28	3	30		SPARE		'	i '		2
29									29		AAA:	0.0	30									3
31									31		***	KKK	32									3
33					SPARE		30	3	33		0.0	866	34	3	30		SPARE			i '		1
27 29 31 33 35 37 39									35		A A A	0.0	36									1
37									37		A-A-A	***	38							·		1
39					SPARE		30	3	39		0.0	KKK	40	3	30		SPARE			i '		4
41									41	***		0.0	42									4
	0	0	0	368	:LOADS BY TYPE												LOADS BY TYPE:		0	156	0	
					TOTAL A	AMPS /	PHASE:			218.0	140.0	166.0	_				TOTAL LOADS BY TYPE:	0	0	156	368	
						KVA /	PHASE:			60.5	38.8	46.1					TOTAL CONNECTED KVA:	145.4				
													-						-			

### GENERAL PANEL CONSTRUCTION NOTES:

- ALL WORK BY THIS CONTRACTOR TO COMPLY WITH ALL LOCAL STATE AND NATIONAL FLECTRICAL CODES
- THIS CONTRACTOR SHALL BE RESPONSIBLE FOR COORDINATION WITH OTHER TRADES TO AVOID CONFLICTS AND TO VERIFY ALL EQUIPMENT CONNECTION REQUIREMENTS.
- THIS CONTRACTOR SHALL BE RESPONSIBLE FOR INSTALLING A COMPLETE ELECTRICAL SYSTEM PER CONTRACT DOCUMENTS AND ENSURING THAT THE SYSTEM IS OPERATIONAL UPON JOB COMPLETION.
- THIS CONTRACTOR SHALL BE RESPONSIBLE FOR INSTALLING A COMPLETE ELECTRICAL SYSTEM FOR ALL OWNER-FURNISHED APPLIANCES IN ACCORDANCE WITH NEC ARTICLE 422 AND 440.22. THE ELECTRICAL CONTRACTOR SHALL FURNISH AND INSTALL ALL BRANCH CIRCUIT WIRING IN ACCORDANCE WITH NATIONAL ELECTRICAL CODE AND THESE PROJECT DOCUMENTS
- PROVIDE ALL POWER WIRING INCLUDING ALL CIRCUITRY CARRYING ELECTRICAL ENERGY FROM PANELBOARD OR OTHER SOURCE THROUGH STARTERS AND DISCONNECTS TO MOTORS, PACKAGED EQUIPMENT, OR PACKAGED
- CONTROL PANELS. PROVIDE ALL WIRING BETWEEN CONTROL PANELS AND MOTORS.
- MOTORS CONNECTED TO EMERGENCY SYSTEMS CIRCUITRY SHALL HAVE CIRCUITRY INSTALLED IN SEPARATE RACEWAY PER NEC ARTICLE 700.
- PROVIDE SEPARATE GREEN GROUND FOR EACH MOTOR AND EQUIPMENT CONNECTION ROUTED BACK TO INTEGRAL GROUND BUS OF ASSOCIATED PANELBOARD OR MOTOR CONTROL CENTER, GROUND CONDUCTOR SIZES PER NEC ARTICLE 250.122.
- ALL HEATING, AIR CONDITIONING AND REFRIGERATION EQUIPMENT INSTALLED ON THE EXTERIOR OF THE BUILDING OR ROOF TOP SHALL HAVE A 15 AMP. 125V WEATHER-RESISTANT GFCI RECEPTACLE SURFACE MOUNTED IN WEATHERPROOF ENCLOSURE, MOUNTED ADJACENT TO EQUIPMENT.
- THIS CONTRACTOR SHALL VERIFY ELECTRICAL REQUIREMENTS INCLUDING VOLTAGE, HORSEPOWER, STARTER TYPE, AND DISCONNECTING MEANS FOR MOTORS AND EQUIPMENT PRIOR TO ORDERING CIRCUIT BREAKERS. DISCONNECT SWITCHES AND STARTERS
- REFER TO ONE-LINE AND P&ID'S FOR ADDITIONAL INFORMATION AND DETIAL.
- REFER TO FEEDER SCHEUDLE FOR ADDITIONAL INFORMATION AND DETIAL.

ANEL NOTES

NA

HEREBY CERTIFY THAT THIS PLAN, REPORT, OR SPECIFICATION WAS PREPARED BY ME OR UNDER MY DIREC SUPERVISION AND THAT I AM A DULY LICENSED PROFESSIONAL ENGINEER UNDER THE LAWS OF THE STATE OF MINNESOT fatt K. Chilin MARCH 25, 2016 44287 SCOTT R. CHILSON Date License No.



LAKEWOOD WTP HVAC SYSTEM IMPROVEMENT CITY OF DULUTH LAKEWOOD, MN

ELECTRICAL SHECUDLES NO.:

00616097 F-23R

# LUMINAIRE SCHEDULE

ABBREVIATIONS	DW	=	DRY WALL	Р	=	PENDANT	S	=	SURFACE
	ES	=	EXPOSED STRUCTURE	PL	=	PLASTER	W	=	WALL MOUNTED
	LG	=	LAY-IN GRID	R	=	RECESSED	V	=	VARIES

DES.	LAMP DA	ATA	DESCRIPTION	LUM	INAIRE		BALLAST/ DRIVER	MOUNT	CATELOG SERIAL #	CEILING	LUMINAIRIE	OPTIONS/	ACCEPTABLE	SEE
	NO.	TYPE		MANUFACTURE	CATELOG SERIES		CODE			TYPE	DEPTH	ACCESSORIES CODE#	MANUFACTURERS	NOTE#
V1	1	LED	ROUGH SERVICE FIXTURE	PHILLIPS	LED	MVOLT	GZ10	٧	FLUXSTREAM EX 4' 3/800Lm 4000K (LF-4-EZ-38-40-U-LAG-FH360-UNV)	٧	~3"	FH360-UNV	OR EQUAL	10-17-A
V2	2	LED	ROUGH SERVICE FIXTURE	LITHONIA	VAP LED	MVOLT	GZ10	V	VAP-4000L-FST-WD-MVOLT-GZ10-40K-80CRI-SF-BSL722-CS89-QMB-MSI10NWL-VAPQMB	V	~4"	VAPQMB	OR EQUAL	10-17-A
EXIT	3	LED	EXIT WITH DUAL EM LAMPS	LITHONIA	LHQMLED	MVOLT	NA	٧	LHQM-LED-WHITE-R-HO-SD	٧	~9"		OR EQUAL	16-A
EM1	2	LED	EMERGENCY LIGHITNG UNIT	LITHONIA	EU2-LED-M12	MVOLT	NA	V	EU2-LED-M12-784231874493-120/277-1.8	٧	~4"			

### OPTIONS/ACCESSORIES CODE LISTING:

- SEMI-SPECULAR REFELECTOR
- 2 LOW IRIDESCENT REFLECTOR
- 3 FLAT ALUMINUM DOOR FRAME
- 4 REGRESSED ALUMINUM DOOR FRAME
- 5 FLAT STEEL DOOR FRAME
- 6 SINGLE GASKET DOOR FRAME
- 7 DOUBLE GASKET DOOR FRAME
- 8 TRIPLE-GASKET DOOR FRAME, LENS, & BODY 9 ANTI-MICROBIAL PROTECTION PAINTED FINISH
- 10 DAMP LOCATION CONSTRUCTION

- 11 WET LOCATION CONSTRUCTION
- 12 STAINLESS STEEL TRIM & DOOR FRAME
- 13 WHITE MILLIGOVE BAFFLE
- 14 BLACK MILLIGROVE BAFFLE
- 15 FURNISH WITH SLOPE ADAPTER VERIFY SLOPE
- 16 FURNISH WITH AUXILIARY EMERGENCY BATTERY PACK
- 17 FURNISH WITH WIRE GUARD
- 18 FURNISH CHAIN MOUNTING ACCESSORIES
- 19 FURNISH WITH RIGID PENDANT STEMS
- 20 FURNISH WITH SWIVEL CANOPY

- 21 FURNISH WITH PHOTO CELL
- 22 FURNISH TRIM SUITABLE FOR USE WITH NARROW TEE CEILING GRID
- 23 CUSTOM PAINTED FINISH COLOR AS SELECTED BY ARCHITECT

# BALLAST CODE LISTING: (SEE SPECIFICATION SECTIONS FOR ADDITIONAL INFORMATION)

- A LED DRIVER, FIXED (NON-DIMMED). LED DRIVER MAY BE DIMMABLE, BUT DIMMING IS NOT REQUIRED FOR THIS FIXTURE.
- B LED DRIVER, STEP-DIM.
- C LED DRIVER, DIMMABLE TO 5%.
- D LED DRIVER, DIMMABLE TO 1%.
- E T8 PROGRAMMED START, NORMAL BALLAST FACTOR 0.87, <10% THD, SYLVANIA QUICKTRONIC HIGH EFFICIENCY SERIES, OR EQUAL BY ADVANCE OR UNIVERSAL.
- F T8 PROGRAMMED START, LOW BALLAST FACTOR 0.77, <10% THD, SYLVANIA QUICKTRONIC HIGH EFFICIENCY SERIES, OR EQUAL BY ADVANCE OR UNIVERSAL.
- G T8 PROGRAMMED START, LOW BALLAST FACTOR 0.71, <10% THD, SYLVANIA QUICKTRONIC HIGH EFFICIENCY SERIES, OR EQUAL BY ADVANCE OR UNIVERSAL.
- H T8 PROGRAMMED START, HIGH BALLAST FACTOR 1.2, <10% THD, SYLVANIA QUICKTRONIC HIGH EFFICIENCY SERIES, OR EQUAL BY ADVANCE OR UNIVERSAL.
- T8 PROGRAMMED START, STEP-DIM, BALLAST FACTOR 0.87/0.37, <10% THD, SYLVANIA QUICKTRONIC PROFESSIONAL SERIES, OR EQUAL BY ADVANCE OR UNIVERSAL.
- J T8 INSTANT START, NORMAL BALLAST FACTOR 0.87, <10% THD, SYLVANIA QUICKTRONIC HIGH EFFICIENCY SERIES, OR EQUAL BY ADVANCE OR UNIVERSAL. K T5HO PROGRAMMED START, 1.0 BALLAST FACTOR, <10% THD, SYLVANIA QUICKTRONIC PROFESSIONAL SERIES, OR EQUAL BY ADVANCE OR UNIVERSAL.
- L T5HO PROGRAMMED START, 1.0 BALLAST FACTOR, <10% THD, SYLVANIA QUICKTRONIC PROFESSIONAL SERIES, OR EQUAL BY ADVANCE OR UNIVERSAL.
- M T5 PROGRAMMED START, 1.0 BALLAST FACTOR, <10% THD, SYLVANIA QUICKTRONIC PROFESSIONAL SERIES, OR EQUAL BY ADVANCE OR UNIVERSAL.
- N H.I.D. LOW FREQUENCY ELECTRONIC UNIVERSAL VOLTAGE, ADVANCE e-VISION, OR EQUAL BY SYLVANIA OR UNIVERSAL.
- O CERAMIC METAL HALIDE (T-6) BALLASTS SHALL BE ADVANCE E-VISION SERIES OR APPROVED EQUAL.
- P PULSE START BALLAST ÀS MANUFACTURED BY SYLVANIA, UNIVERSAL, OR ADVANCE.
- Q PULSE START BALLAST AS MANUFACTURED BY SYLVANIA, UNIVERSAL, OR ADVANCE.

# GENERAL LUMINAIRE SCHEDULE NOTES:

- 9 SEE SPECIFICATION SECTION FOR ADDITIONAL INFORMATION REGARDING LUMINAIRE AND INSTALLATION REQUIREMENTS. PROVIDE OPTIONS AND ACCESSORIES REFERENCED BY THE COLUM TITLED "OPTIONS/ACCESSORIES". MANUFACTURES LISTED AS ACCEPTABLE SHALL MEET ALL REQUIREMENTS AND FEATURES INDICATED. ACCEPTABLE MANUFACTUREERS MUST MEET THE PHOTOMETRIC PERFORMANCE OF THE LISTED UNIT.
- MANUFACTURE NAMES AND CATELOG NUMBERS ARE USED FOR QUALITY AND PERFOMANCE ONLY. LUMINARES AND OTHER ELECTRICAL DEVICES MANUFACTUREED BY OTHERS SHALL BE EQUALLY ACCEPTABLE PROVIDED THEY MEET OR EXCEED IN PERFORMANCE AND QUALITY AS SPECIFIED.
- ALL FLUORESCENT LAMP/BALLAST LAMP/BALLASTS WIRED TO THE DIMMING SYSTEM SHALL BE BURNED-IN FOR A MINIMUM OF 100 HOURS PRIOR TO DIMMING SYSTEM SET-UP/PROGRAMMING
- EACH FLUORESCENT LUMINAIRE SHALL BE SUPPLIED WITH QUICK DISCONNECTING MEANS FOR ALL BALLASTS AS REQURED BY NEX 410.73. PROVIDE THOMAS AND BETTS LD2 OR LD3 OR EQUAL.
- ALL SELECTION ARE BEST ATTEMPT TO IDENTIFY THE CORRECT ITEM. THE SUPPLIER SHALL COORDINATE AND CONFIRM ALL SELECTION AND APPLCIAITONS BASED ON THE INTENT OF THE CONTRACT.

# <u>LUMINAIRE SCHEDULE NOTES:</u>

•

OJECT NO.:	00616097	SCALE: AS SHOWN	NO.	DATE	REVISION	BY	I HEREBY CERTIFY THAT THIS PLAN, REPORT, OR SPECIFICATION	WAS PREPARED BY ME OR U	NDER MY DIREC
OJECT DATE:	MARCH 2016	DRAWN BY: INIT	1	3/25	ADDENDUM #1		SUPERVISION AND THAT I AM A DULY LICENSED PROFESSIONAL	ENGINEER UNDER THE LAWS (	OF THE STATE (
k:	-	CHECKED BY: SRC					Lett R. Cluber	MARCH 25, 2016	44287
							SCOTT R. CHILSON	Date	License No.
OT DATE: 3/25/1	B-\610e\616\0061	I6097/CADD/Construction D	ocumon	te\ADDENDI	IM #1/616007 E-24P dwg		00011111011120011	Date	LICEIISE INC.

RECT TE OF MINNESOTA.

MSA

O. TRANSPORTATION - MUNICIPAL

DEVELOPMENT - ENVIRONMENTAL

332 W. Superior Street Duluth, MN 55802

218-722-3915 1-800-777-7380 Fax: 218-722-4548

Web Address: www.msa-ps.com

CITY OF DULUTH
LAKEWOOD, MN

ELECTRICAL SCHEDULES NO.3

FILE NO. 00616097 SHEET E-24R

		MOTOR AND		MPARISON S	CHEDULE		FXIS	TING		
		10	AD		WER		Date		VER	
TAG NUMBER	EQUIPEMENT/DEVICE/MOTOR DESCRIPTION	(HP)	(AMPS)	(VOLTS)	(PHASE)	(HP)	(AMPS)	(VOLTS)	(PHASE)	NOTES
MP-1	SAMPLER PUMP NO.1	~1	16	120	1	~1	L4	120	1	1,2
MP-2	SAMPLER PUMP NO.2	~1	16	120	1	~1	L4	120	1	1,2
<del>-</del> -1	EXHAUST FAN NO.1	1.5	3	480	3	0.5	MCC-A	480	3	1,2
F-2 F-3	EXHAUST FAN NO.2	0.75	4.8 1.6	480 480	3	5 0.5	MCC-A MCC-A	480 480	3	1,2
F-4	EXHAUST FAN NO.3 EXHAUST FAN NO.4	0.75	1.6	480	3	0.75	MCC-A	480	3	1,2 1,2
F-5	EXHAUST FAN NO.5	0.75	9.8	120	1	0.75	MCC-A	480	3	1,2
F-6	EXHAUST FAN NO.6	0.5	9.8	120	1	TBD	L4	120	1	1,2
F-7	EXHAUST FAN NO.7	0.02	4.4	120	1	TBD	L4	120	1	1,2
F-8	EXHAUST FAN NO.8	0.25	5.8	120	1	TBD	L4	120	1	1,2
F-9	EXHAUST FAN NO.9	0.02	4.4	120	1	TBD	L4	120	1	1,2
HU-1	AIR HANDLING UNIT NO.1	7.5	11	480	3	5	MCC-A	480	3	1,2
HU-2	AIR HANDLING UNIT NO.2	3 2	4.8	480	3	5	MCC-A	480	3	1
HU-3 -1	AIR HANDLING UNIT NO.3  DESICCANT DEHUMIDIFIER NO.1	COMBINED	3.3	480 480	3	3 NA	MCC-A NA	480 NA	3 NA	1,2
-1	DESICCANT DEHOMIDIFIER NO.1 (SUPPLY FAN)	15	21	480	3	NA NA	NA NA	NA NA	NA NA	1,3 1,3
	DESICCANT DEHUMIDIFIER NO.1 (EXHAUST FAN)	3	4.8	480	3	NA	NA	NA	NA	1,3
	DESICCANT DEHOMIDIFIER NO.1 (REGENERATION FAN)	3	4.8	480	3	NA	NA	NA	NA	1,3
-2	DESICCANT DEHUMIDIFIER NO.2	COMBINED	20	480	3	NA	NA	NA	NA	1,3
	DESICCANT DEHUMIDIFIER NO.1 (SUPPLY FAN)	10	14	480	3	NA	NA	NA	NA	1,3
	DESICCANT DEHUMIDIFIER NO.1 (EXHAUST FAN)	NA	NA	480	3	NA	NA	NA	NA	1,3
	DESICCANT DEHUMIDIFIER NO.1 (REGENERATION FAN)	3	4.8	480	3	NA	NA	NA	NA	1,3
D-1	MOTORIZED DAMPER NO.1	0.1	2.6	120	1	TBD	MCC-A	480	TBD	1,2
D-2	MOTORIZED DAMPER NO.2	0.1	2.6	120	1	TBD	MCC-A	480	TBD	1,2
D-3	MOTORIZED DAMPER NO.3	0.1	2.6	120	1	TBD	TBD	TBD	TBD	1,2
D-4 D-5	MOTORIZED DAMPER NO.4 MOTORIZED DAMPER NO.5	0.1	2.6 2.6	120	1	TBD TBD	MCC-A MCC-A	480 480	TBD TBD	1,2
D-6	MOTORIZED DAMPER NO.6	0.1	2.6	120 120	1	TBD	MCC-A	480	TBD	1,2 1,2
D-7	MOTORIZED DAMPER NO.7	0.1	2.6	120	1	TBD	MCC-A	480	TBD	1,2
D-8	MOTORIZED DAMPER NO.8	0.1	2.6	120	1	TBD	TBD	TBD	TBD	1,2
D-9	MOTORIZED DAMPER NO.9	0.1	2.6	120	1	TBD	TBD	TBD	TBD	1,2
D-10	MOTORIZED DAMPER NO.10	0.1	2.6	120	1	TBD	TBD	TBD	TBD	1,2
D-11	MOTORIZED DAMPER NO.11	0.1	2.6	120	1	TBD	TBD	TBD	TBD	1,2
D-12	MOTORIZED DAMPER NO.12	0.1	2.6	120	1	TBD	TBD	TBD	TBD	1,2
D-13	MOTORIZED DAMPER NO.13	0.1	2.6	120	1	TBD	TBD	TBD	TBD	1,2
ID-14	MOTORIZED DAMPER NO.14	0.1	2.6	120	1	TBD	TBD	TBD	TBD	1,2
D-15	MOTORIZED DAMPER NO.15	0.1	2.6	120	1	TBD	TBD	TBD	TBD	1,2
ID-16 -1 = H-1	MOTORIZED DAMPER NO.16 HEATING SYSTEM PUMP NO.1	0.1	2.6 4.8	120 208	3	TBD 3	TBD MCC-A	TBD 480	TBD 3	1,2 1,2
-VFD-1	HEATING SYSTEM PUMP NO.1 VFD CONTROL PANEL	3+	~15	208	3	3	MCC-A	480	3	1,2
-2	HEATING SYSTEM PUMP NO.2	3	4.8	208	3	3	MCC-A	480	3	1,2
VFD-2 = H-2	HEATING SYSTEM PUMP NO.2 VFD CONTROL PANEL	3+	~15	208	3	3	MCC-A	480	3	1,2
H-1	UNIT HEATER NO.1	1/20	0.8	120	1	TBD	LP-L4A	120	1	1,2
H-2	UNIT HEATER NO.2	1/20	0.8	120	1	TBD	LP-L4A	120	1	1,2
H-3	UNIT HEATER NO.3	1/20	0.8	120	1	TBD	LP-L4A	120	1	1,2
<del>1</del> -4	UNIT HEATER NO.4	1/20	0.8	120	1	TBD	LP-L4A	120	1	1,2
1-5	UNIT HEATER NO.5	1/20	2	120	1	TBD	LP-L4A	120	1	1,2
H-6 H-7	UNIT HEATER NO.6	1/20 1/20	0.8	120 120	1	TBD TBD	LP-L4A	120 120	1	1,2
1- <i>1</i> 1-8	UNIT HEATER NO.7 UNIT HEATER NO.8	1/20	0.8	120	1	TBD	LP-L4A LP-L4A	120	1	1,2 1,2
1-9	UNIT HEATER NO.9	TBD	0.26	120	1	TBD	LP-L4A	120	1	1,2
1-10	UNIT HEATER NO.10	TBD	0.26	120	1	TBD	TBD	TBD	TBD	1,2
I-11	UNIT HEATER NO.11	1/20	0.8	120	1	TBD	TBD	TBD	TBD	1,2
I-12	UNIT HEATER NO. 12	1/20	0.8	120	1	TBD	TBD	TBD	TBD	1,2
H-13	UNIT HEATER NO.13	1/20	0.8	120	1	TBD	MCC-A	480	3	1,2
1-14	UNIT HEATER NO.14	1/20	0.8	120	1	TBD	MCC-A	480	3	1,2
H-15	UNIT HEATER NO. 15	TBD	0.26	120	1	TBD	LP-L4A	120	1	1,2
I-16 I-17	UNIT HEATER NO. 16 UNIT HEATER NO. 17	TBD TBD	0.26 0.16	120 120	1	TBD TBD	LP-L4A LP-L4A	120	1	1,2
1-1 <i>1</i> 1-18	UNIT HEATER NO.17 UNIT HEATER NO.18	1/20	0.16	120	1	TBD	TBD	120 TBD	1 TBD	1,2 1,2
1-10 1-19	UNIT HEATER NO. 19	1/20	0.8	120	1	TBD	TBD	TBD	TBD	1,2
1-20	UNIT HEATER NO.20	1/20	0.8	120	1	TBD	TBD	TBD	TBD	1,2
H-21	UNIT HEATER NO.21	1/20	0.8	120	1	TBD	TBD	TBD	TBD	1,2
1-22	UNIT HEATER NO.22	1/20	0.8	120	1	TBD	TBD	TBD	TBD	1,2
<del>1</del> -23	UNIT HEATER NO.23	1/20	0.8	120	1	TBD	TBD	TBD	TBD	1,2
H-24	UNIT HEATER NO.24	1/20	0.8	120	1	TBD	TBD	TBD	TBD	1,2
1-25	UNIT HEATER NO.25	1/20	0.8	120	1	TBD	TBD	TBD	TBD	1,2
1-26	UNIT HEATER NO.26	TBD	0.26	120	1	TBD	TBD	TBD	TBD	1,2
W-XFMR-L4B	L4B TRANSFORMER	30 Kva	36	480	3	5 kVA	21	240 TRD	1 TDD	1,4
P-L4B	LIGHTING AND APPLIANCE PANEL L4B	NA NA	NA	208/120	3	TBD	TBD	TBD	TBD	1,3
P-L4A	LIGHTING AND APPLIANCE PANEL L4A	NA	NA 13.3	208/120 120	1	TBD	TBD L4	240/120 120	1	1,3 1,3

# NOTE(S):

(INFORMATION PROVIDED IS THE BEST INFORMATION AVAILABE. THE CONTRACTOR SHALL PROVIDE PRECONSTRUCTION INSPECTION TO VERIFY ALL CONNECTION ARE CONSISTANT AND RELATIVELY SIMILAR FOR THE PROPOSED APPLICATION.)

(THE CONTRACTOR SHALL NOTE THAT SOME DEVICES ARE FEED AC, BUT HAVE LOCAL DC XFMRS.)

- CONTRACTOR SHALL FIELD VERFIY ALL EXISTING CONNECTION AND WIRING. ANY DESCRANCIES FROM THE INFROMATION PROVIDED SHALL BE SUBMITTED TO THE ENGINEER 1. PRIOR TO CONSTRUCTION.
- WHEN PROPOSED EQUIPMENT POWER REQUIREMENTS ARE DIFFERENT THAN THE EXSITNG, THEN: DEMOLISH EXSITNG AND FURNISH AND INSTALL NEW RACEWAY AND POWER 2. CIRCUIT FROM NEAREST POWER DISTRIBUITON PANEL.
- 3. FURNISH AND INSTALL NEW RACEWAY AND POWER CIRCUIT FROM NEAREST POWER DISTRIBUTION PANEL
- 4. FURNISH NEW CB BUCKET AND FEEDER IN EXISING RACEWAY FROM WTP-MCC-A

PROJECT NO.:	00616097	SCALE: AS SHOWN	NO.	DATE	REVISION	BY
PROJECT DATE:	MARCH 2016	DRAWN BY: INIT	1	3/25	ADDENDUM #1	
F.B. :		CHECKED BY: SRC	. '	· '		

HEREBY CERTIFY THAT THIS PLAN, REPORT, OR SPECIFICATION WAS PREPARED BY ME OR UNDER MY DIRECT SUPERVISION AND THAT I AM A DULY LICENSED PROFESSIONAL ENGINEER UNDER THE LAWS OF THE STATE OF MINNESOTA SCOTT R. CHILSON

MARCH 25, 2016 44287 Date License No.



LAKEWOOD WTP HVAC SYSTEM IMPROVEMENTS CITY OF DULUTH

LAKEWOOD, MN

**ELECTRICAL SHCEUDLES NO.4** 

FILE NO.
00616097
SHEET
E-25R

Exterior/Non-Hazardous	ALL	ALL	Underground	PVC	REFER TO SPEC.	PVC	PGRS/GAL /PVC	PGRS/ GAL / PVC	AS REQUIRE
Exterior/ Nor-mazardous	ALL	ALL	Grada ground	FVC	REFER TO SPEC.	FVC			AS REQUIN
Interior/ Dry / Non-Hazardous	ALL	ALL	Exposed	EMT	REFER TO SPEC.	GS	PGRS/ GAL / PVC	PGRS/ GAL / PVC	AS REQUIR
Interior/ Dry / Non-Hazardous	ALL	ALL	Concealed	EMT	REFER TO SPEC.	GS	PGRS/ GAL / PVC	PGRS/ GAL / PVC	AS REQUIR
Interior/ Wet / Non-Hazardous	ALL	ALL	Exposed	PGRS/PVC	REFER TO SPEC.	PGRS CAST/PVC	PGRS/ GAL / PVC	PGRS/ GAL / PVC	AS REQUIR
Interior/ Wet / Non-Hazardous	ALL	ALL	Concealed	PGRS/PVC	REFER TO SPEC.	PGRS CAST/PVC	PGRS/ GAL / PVC	PGRS/GAL/ PVC	AS REQUIR
Interior/ Dry / Corrosive	ALL	ALL	Exposed	PGRS/PVC	REFER TO SPEC.	PGRS CAST/PVC	PGRS/GAL /PVC	PGRS/GAL/ PVC	AS REQUIRE
Interior/ Dry / Corrosive	ALL	ALL	Concealed	PGRS/PVC	REFER TO SPEC.	PGRS CAST/PVC	PGRS/GAL /PVC	PGRS/GAL/ PVC	AS REQUIRE
Interior/ Wet / Corrosive	ALL	ALL	Exposed	PGRS/PVC	REFER TO SPEC.	PGRS CAST/PVC	PGRS/GAL /PVC	PGRS/GAL/ PVC	AS REQUIRE
Interior/ Wet / Corrosive	ALL	ALL	Concealed	PGRS/PVC	REFER TO SPEC.	PGRS CAST/PVC	PGRS/ GAL / PVC	PGRS/GAL/ PVC	AS REQUIRE
CONDUIT & BOX SO	HEDUL	<u>E</u>							
NOTES:									
1	All conduit :	and racow ave	shall be concealed	w hon noceible					
		-							
4	Transition to	ions snail be a	allow ed uniess writ	ten permission to the cont	for exposed conduit re	rom engineer.	other transitie	un in rigid or flow	ible Embedded
3	transitions	shall be rigid n	naterial	ith specified requirements	Tor exposed coridati, re	gardiess or with	eu lei u al isiuc	iris rigiu or nex	ible. Dibeaded
				rea shall be enamel coate					
					u garvanizeu steer ur bri	isi leu aluminum			
			sh and install wire o						
				equipment connections. L					
				equipment connections. L			be permitted.		
8	AFD motor 1	feeders shall l	oe installed in PGRS	conduit or Insulated AFD	Motor cables installed in	PVC.			
				the faciltiy shall be painte					
	install painte			el is not advised for the o are and related materials		ct on the interior	off this faclit	y. CONTRACTO	OR shall furinsh ar
11		New Bectircal	Materials. Refer to	schedule.					
ABBREVIATIONS:									
	Conduit			Supports &	Hardware				
	PVC:	Schedule 40	Digid DVC	опррогио о					
	GRS:	Galvanized	-	GS		Galvanized St	s of		
			-						
	PGRS:	PVC-Coated		SS		Stainless Stee	1		
	EMT:	Electrical Me	-	PVC40		SCH 40 PVC			
	HDPE:	High Density	Polyethylene	PVC80		SCH 80 PVC			
				ZPS		Zinc Plated Ste			
	Boxes			PCS		PVC Coated S	teel		
	SB:	Steel Box		S		Steel			
	OB:	Cast Box		AL		Aluminum			
	PCB:	PVC-Coated	Cast Box						

Area Classification Voltage Type Installation

CONDUIT & BOX SCHEDULE

Use Box Supports Hardware Location

PGRS/ GAL PVC

PGRS/ GAL PGRS/ GAL / PVC PVC

PGRS/GAL /PVC

			COMPRESSOR									WIRING				E AND WIRING SCHEDULE													$\overline{}$
	EQUIPEMENT/DEVICE/MOTOR DESCRIPTION	STATUS EXISTING / PROPOSED / REPLACMENT / RELOCATE	EQUIPMENT/DEVICE DISGNATOR (DEVICE / MOTOR / PANEL / DISCONNECT / OTHER)	E	LOAD			POWER		BREA	BREAKER		мото	MOTOR CONTROLLER		LOCAL EQUIPMENT DISCONNECT		ECT	FIRST SIGNAL/CONTROL CONDUIT			SECOND SIGNAL/CONTROL CONDUIT			POWER CONDUIT				
TAG NUMBER				LOCATION	(KVA)	(HP)	(AMPS)	(VOLTS)	(PHASE)	(SIZE)	(POLE)	(AMP#G)	ТҮРЕ	SIZE	BY	(TYPE)	(SIZE) (FI	U SED)	(BY)	DESTINATIO	N TYPE	WIRING	DESTINATION	TYPE	WIRING	DESTINATION	TYPE	WIRING	NOTES
SMP-1 SMP-2	SAMPLER PUMP NO 2	RE LOCATE RE LOCATE	M OTOR M OTOR	106 106	NA NA	~1	16	120 120	1	EXISTING EXISTING	NA NA	10-4G	EXISTING EXISTING		M C	NFMP NFMP		NA NA	EC	EXISTING EXISTING	E XISITNG E XISITNG	EXISITNG EXISITNG	E XISITNG F XISITNG	EXISITNG EXISITNG	EXISITNG EXISITNG	LP-L4B	PWR PWR	35-4G 35-4G	1,5,7 1,5,7
EF-1	EXHAUST FAN NO.1	REPLACEMENT	T MOTOR	Roof	NA	1.5	3	480	3	EXISTING	3	20-3G	FVNR	EXISTING	MC	NFMP	30	NA	EC	TBD BY MC	TBD BY MC	TBD BYMC	TBD BY MC	TBD BYMC	TBD BY MC	WTP-MCC-A	PWR	15-3G	1,3,4,7,8
EF-2	EXHAUST FAN NO.2 EXHAUST FAN NO.3	REPLACEMENT REPLACEMENT	T MOTOR T MOTOR	Roof			4.8 1.6	480 480	3	EXISTING EXISTING	3	20-3G 20-3G	FVNR FVNR	EXISTING EXISTING	M C	NFMP NFMP		NA NA	EC	TBD BY MC	TBD BY MC	TBD BYMC		TBD BYMC	TBD BY MC	WTP-MCC-A	PWR PWR	15-3G 15-3G	1,3,4,7,8 1,3,4,7,8
EF-4	EXHAUST FAN NO.4	REPLACEMENT	T MOTOR	Roof	NA	0.75	1.6	480	3	EXISTING	3	20-3G 20-2G	FVNR	EXISTING	MC	NEMP	30	NA	EC	TBD BY MC	TBD BY MC	TBD BYMC TBD BYMC	TBD BY MC	TBD BY M C	TBD BY MC	WTP-MCC-A	PWR	15-3G 20-3G	1,3,4,7,8
EF-5	EXHAUST FAN NO.5 EXHAUST FAN NO.6	REPLACEMENT REPLACEMENT	T MOTOR T MOTOR	Roof Roof	NA NA	0.5	9.8 9.8	120	1	EXISTING EXISTING	1		FVNR FVNR	NEMA 1	MC	NFMP NFMP		NA NA	EC	TBD BY MC	TBD BY MC TBD BY MC	TBD BYMC	TBD BY MC	TBD BYMC TBD BYMC	TBD BY MC	LP-L4B LP-L4B	PWR		1,3,4,7,8
EF-7	EXHAUST FAN NO.7	REPLACEMENT	T MOTOR	Roof		0.02	4.4	120	1	EXISTING	1	20-2G 20-2G	FVNR	NEMA 1	MC	NEMP		NA	EC	TBD BY MC	TBD BY MC	TBD BYMC	TBD BY MC	TBD BYMC	TBD BY MC	LP-L48	PWR	15-2G 15-2G	1,3,4,7,8 1,3,4,7,8
EF-8 EF-9	EXHAUST FAN NO.8 EXHAUST FAN NO.9	REPLACEMENT REPLACEMENT	T MOTOR T MOTOR	Roof			5.8	120 120	1 1	EXISTING EXISTING	1	20-2G	FVNR	NEMA 1 NEMA 1	MC	NEMP NEMP		NA NA	EC	TBD BY MC	TBD BY MC	TBD BYMC TBD BYMC	TBD BY MC TBD BY MC	TBD BYMC TBD BYMC	TBD BY MC	LP-L4B LP-L4B	PWR PWR	15-2G 15-2G	1,3,4,7,8 1,3,4,7,8
ENV-1	E NE RGY RE COVERY UNIT	PROPOSED	MOTOR	107	NA NA	0.02 NA	4.4 NA	NA	NA	NA	NA	20-2G NA	NA	NA	NA	NA	NA	NA	NA	NA NA	TBD BY MC NA	NA NA	NA	NA	NA	NA	NA	NA	1,6
AHU-1 AHU-VFD-1	AIR HANDLING UNIT NO.1 AIR HANDLING UNIT NO.1 VFD MOTOR CONTROLLER	REPLACEMENT REPLACEMENT	T MOTOR	107	NA NA	7.5	11	480	3	MCP	3	VFD CABLE	VFD VFD	TBD TBD	MC	NFMP	30	NA 20		AHU-VFD-1 HVAC-TCP-1	DICRETE SIGNAL DISCRETE SIGNAL	D4	TBD BY MC HVAC-TCP-1	TBD BYMC ANALOG SIGNAL	TBD BY MC	AHU-VFD-1 WTP-MCC-A	480 VAC 480 VAC	VFD CABLE 30-4G	1,6 1,3,9 1,2,5,8,9
AHU-2	AIR HANDLING UNIT NO.2	DEMOLISH	MOTOR	107	NA NA	3	4.8	480 480	3	NA.	NA.	30-4G NA	NA.	NA.	NA	MCB NA	NA NA	20 NA	E C NA	NA NA	NA	NA NA	NA NA	NA NA	NA.	NA NA	NA NA	NA NA	1
AHU-3	AIR HANDLING UNIT NO.3	REPLACEMENT	T MOTOR	217	NA	2	3.3	480	3	MCP	3	20-3G	FVNR	TBD	MC	NFMP	30	NA		TBD BY MC	TBD BY MC	TBD BYMC	TBD BY MC	TBD BYMC	TBD BY MC	AHU-MC-3 WTP-MCC-A	480 VAC	20-3G 20-4G	1,3,9 1,2,5,8,9
AH U-M C-3 AD	AIR HANDLING UNIT NO.3 MOTOR CONTROLLER AIR DRYER	DE MOLISH	MOTOR	107	NA NA	NA	4.8 NA	480 NA	NA.	NA NA	NA.	30-4G NA	FVNR NA	TBD NA	M.C. NA	MCB NA	NA NA	NA NA	NA	NA NA	DISCRETE SIGNAL NA	NA.	TBD BY MC	TBD BYMC NA	NA NA	NA NA	480VAC NA	NA	1,6
D-1	DESICCANT DE HUMIDIFIER NO.1	PROPOSED	PANEL	OUTSIDE	~30	COMBINED	30	480	3	40	3	40-4G	PER MFR	PERMFR	PER MFR	PERMFR	PER MFR PE	RMFR	MC	TBD BY MC	TBD BY MC	TBD BYMC	TBD BY MC	TBD BYMC	TBD BY MC	PP-1	480/277VAC	40-4G	1,2,5,8,9
	DESICCANT DE HUMIDIFIER NO.1 (SUPPLY FAN) DESICCANT DE HUMIDIFIER NO.1 (EXHAUST FAN)	PROPOSED PROPOSED	MOTOR	OUTSIDE	NA NA	3	4.8	480 480	3								PERMFR PE	LZ III L LZ		TBD BY MC TBD BY MC TBD BY MC	TBD BY MC	TBD BYMC	TBD BY MC TBD BY MC	TBD BYMC TBD BYMC	TBD BY MC			+	1,2,5,8,9 1,2,5,8,9
	DESICCANT DEHUMIDIFIER NO.1 (REGENERATION FAN)	PROPOSED	M OTOR	OUTSIDE	NA	3	4.8	480	3				PER MFR	PERMFR	PER MFR	PERMFR	PER MFR PE	RMFR			TBD BY MC	TBD BYMC	TBD BY MC	TBD BYMC	TBD BY MC				1,2,5,8,9
D-2	DESICCANT DE HUMIDIFIE R NO.2 DESICCANT DE HUMIDIFIE R NO.1 (SUPPLY FAN)	PROPOSED PROPOSED	PANE L M OTOR	107	~21 NA	COMBINED 10	20 14	480 480	3	30	3	30-4G	PER MFR	PERMFR	PER MFR	PERMFR	PERMFR PE	RMFR	M C	TBD BY MC TBD BY MC	TBD BY MC TBD BY MC	TBD BYMC TBD BYMC	TBD BY MC TBD BY MC	TBD BYMC TBD BYMC	TBD BY MC TBD BY MC	PP-1	480/277VAC	30-4G	1,2,5,8,9 1,2,5,8,9
	DESICCANT DE HUMIDIFIER NO.1 (EXHAUST FAN)	PROPOSED	M OTOR	107	NA	NA	NA	480	3				PER MFR	PERMFR	PER MFR	PERMFR	PERMFR PE	RMFR	MC	TBD BY MC	TBD BY MC	TBD BYMC	TBD BY MC	TBD BYMC	TBD BY MC			1	1,2,5,8,9
AFMS-1	DESICCANT DEHUMIDIFIER NO.1 (REGENERATION FAN) AIR FLOW MEASURING STATION	PROPOSED PROPOSED	M OTOR DEVICE	107	NA 1	NA	4.8 6.7	480 120	3	NΔ	NΔ	NΔ	PER MFR NA	PERMFR NA	PER MFR	PERMFR NA	PER MFR PE	R M FR NA	M C NA	TBD BY MC	TBD BY MC	TBD BYMC	TBD BY MC	TBD BYMC	TBD BY MC	NA	NA	NA	1, 2, 5, 8, 9
VAV-1 VAV-3	VAV CONTROL UNIT NO.1	PROPOSED	DEVICE	107	0.25	NA	2.6	120	1	NA	NA	NA	NA	NA	NA	NA	NA	NA	NA	TBD BY MC	TBD BY MC	TBD BYMC	TBD BY MC	TBD BYMC	TBD BY MC	TBD BY MC	TBD BY MC	TBD BY MC	1,6 1,6
VAV-3 VAV-4	VAV CONTROL UNIT NO.1 VAV CONTROL UNIT NO.1	PROPOSED PROPOSED	DEVICE	107	0.25	NA NA	2.6	120 120	1	NA NA	NA NA	NA NA	NA NA	NA NA	NA NA	NA NA		NA NA	NA NA	TBD BY MC TBD BY MC	TBD BY MC TBD BY MC	TBD BYMC TBD BYMC	TBD BY MC TBD BY MC	TBD BYMC TBD BYMC	TBD BY MC	TBD BY MC TBD BY MC	TBD BY MC TBD BY MC	TBD BY MC TBD BY MC	1,6 1,6
VAV-5	VAV CONTROL UNIT NO.1	PROPOSED	DEVICE	107	0.25	NA NA	2.6	120	1	NA NA	NA NA	NA NA	NA NA	NA NA	NA NA	NA NA	NA NA	NA NA	NA NA	TBD BY MC	TBD BY MC	TBD BYMC	TBD BY MC	TBD BYMC	TBD BY MC	TBD BY MC	TBD BY MC	TBD BY MC	1,6
VAV-6	VAV CONTROL UNIT NO.1	PROPOSED PROPOSED	DEVICE	217	0.25	NA	2.6	120	1	NA	NA	NA 00.00	NA	NA	NA	NA		NA	NA	TBD BY MC	TBD BY MC	TBD BYMC	TBD BY MC	TBD BYMC	TBD BY MC	TBD BY MC	TBD BY MC	TBD BY MC	1,6
MD-1 MD-2	M OTORIZED DAMPER NO.1 M OTORIZED DAMPER NO.2	PROPOSED	M OTOR M OTOR	107	0.25	0.1	2.6	120	1	20	1	20-2G 20-2G	TBD	TBD TBD	MC	NFMP NFMP		NA NA	EC	TBD BY MC	TBD BY MC	TBD BYMC	TBD BY MC TBD BY MC	TBD BYMC TBD BYMC	TBD BY MC	LP-L4A OR B LP-L4A OR B	120VAC 120VAC	20-2G 20-2G	1,3,5,8 1,3,5,8
MD-3	M OTORIZED DAMPER NO.3	PROPOSED	M OTOR	218	0.25	0.1	2.6	120	1	20	1	20-2G	TBD	TBD	MC	NEMP	20	NA	EC	TBD BY MC	TBD BY MC	TBD BYMC	TBD BY MC	TBD BYMC	TBD BY MC	LP-L4A OR B	120VAC	20-2G	1.3.5.8
MD-4	M OTORIZED DAMPER NO.4 M OTORIZED DAMPER NO.5	PROPOSED PROPOSED	M OTOR	116 116	0.25 0.25	0.1	2.6	120 120	1 1	20	1	20-2G 20-2G	TBD	TBD	MC	NFMP NFMP		NA NA	EC	TBD BY MC	TBD BY MC TBD BY MC	TBD BYMC TBD BYMC	TBD BY MC TBD BY MC	TBD BYMC TBD BYMC	TBD BY MC	LP-L4A OR B	120VAC 120VAC	20-2G 20-2G	1,3,5,8
MD-6	M OTORIZED DAMPER NO.6	PROPOSED	M OTOR M OTOR	115	0.25	0.1	2.6	120	1	20	i	20-2G	TBD	TBD	MC	NEMP	20	NA		TBD BY MC	TBD BY MC	TBD BYMC	TBD BY MC	TBD BYMC	TBD BY MC TBD BY MC	LP-L4A OR B	120VAC	20-2G	1,3,5,8 1,3,5,8
MD-7	M OTORIZED DAMPER NO.7 M OTORIZED DAMPER NO.8	PROPOSED PROPOSED	M OTOR M OTOR	115 202	0.25	0.1	2.6	120 120	1	20	1	20-2G 20-2G	TBD	TBD TBD	MC	NFMP NFMP		NA NA		TBD BY MC	TBD BY MC	TBD BYMC TBD BYMC	TBD BY MC	TBD BYMC TBD BYMC	TBD BY MC TBD BY MC	LP-L4A OR B LP-L4A OR B	120VAC 120VAC	20-2G 20-2G	1,3,5,8 1,3,5,8
MD-9	M OTORIZED DAMPER NO.9	PROPOSED	M OTOR M OTOR	107	0.25	0.1	2.6	120	1	20	1	20-2G		TBD	MC	NEMP	20	NA		TBD BY MC	TBD BY MC	TBD BYMC TBD BYMC	TBD BY MC	TBD BYMC TBD BYMC	TBD BY MC TBD BY MC	LP-L4A OR B	120VAC	20-2G 20-2G 20-2G	1,3,5,8 1,3,5,8
MD-10	M OTORIZED DAMPER NO.10 M OTORIZED DAMPER NO.11	PROPOSED PROPOSED	M OTOR M OTOR	217	0.25	0.1	2.6	120	1	20	1	20-2G 20-2G	TBD	TBD	MC	NFMP NFMP		NA NA	EC	TBD BY MC	TBD BY MC	TBD BYMC	TBD BY MC	TBD BYMC	TBD BY MC	LP-L4A OR B LP-L4A OR B	120VAC	20-2G	1,3,5,8 1,3,5,8
MD-11 MD-12	M OTORIZED DAMPER NO.11	PROPOSED	MOTOR	ROOF	0.25	0.1	2.6	120	1	20	1	20-2G	TBD	TBD	MC	NEMP		NA NA	EC	TBD BY MC	TBD BY MC	TBD BY M C		TBD BYMC	TBD BY MC	LP-L4A OR B	120VAC 120VAC	20-2G 20-2G	1,3,5,8
MD-13	M OTORIZED DAMPER NO.13	PROPOSED	M OTOR	ROOF	0.25		2.6	120	1	20	1	20-2G	TBD	TBD	MC	NFMP		NA	EC	TBD BY MC	TBD BY MC	TBD BYMC	TBD BY MC	TBD BYMC TBD BYMC	TBD BY MC	LP-L4A OR B	120VAC	20-2G 20-2G	1,3,5,8 1,3,5,8
MD-14 MD-15	M OTORIZED DAMPER NO.14 M OTORIZED DAMPER NO.15	PROPOSED PROPOSED	M OTOR M OTOR	ROOF	0.25	0.1	2.6	120 120	1	20	1	20-2G 20-2G		TBD TBD	M C	NFMP NFMP		NA NA	EC	TBD BY MC	TBD BY MC	TBD BYMC	TBD BY MC TBD BY MC	TBD BYMC	TBD BY MC TBD BY MC TBD BY MC	LP-L4A OR B LP-L4A OR B	120VAC 120VAC	20-2G 20-2G	1,3,5,8
MD-16	M OTORIZED DAMPER NO.16	PROPOSED	MOTOR	ROOF	0.25		2.6	120	1	20	1	20-2G	TBD	TBD	MC	NEMP		NA	EC	TBD BY MC	TBD BY MC	TBD BYMC	TBD BY MC	TBD BYMC	TBD BY MC	LP-L4A OR B	120VAC	20-2G	1,3,5,8 1,3,5,8
P-1= H-1 P-VFD-1	HEATING SYSTEM PUMP NO.1 HEATING SYSTEM PUMP NO.1 VFD CONTROL PANEL	PROPOSED	PANEL	107	NA NA	3+	4.8 ~15	208	3	MCP 30	3	VFD CABLE 20-4G	VFD	3HP	MC	NFMP MCP	NA 30	NA NA	EC	TBD BY MC HVAC-TCP-1	TBD BY MC DISCRETE SIGNAL	TBD BYMC	TBD BY MC HVAC-TCP-1	TBD BYMC ANALOG SIGNAL	TBD BY MC	P-VFD-1 DC	SHEILDED MTR CAI	LE 20-3G 30-4G	1,3,5,7 1,3,5,7
P-2 = H-1	HEATING SYSTEM PUMP NO.2	PROPOSED	M OTOR	107	NA	3	4.8	208	3	MCP	3	VFD CABLE	VFD	3HP	MC	NFMP	NA	8	EC	P-VFD-2	DISCRETE SIGNAL	D2				P-VFD-2	SHEILDED MTR CAL	JLE 20-3G	1,3,5,7 1,3,5,7
P-VFD-2	HEATING SYSTEM PUMP NO.2 VFD CONTROL PANEL UNIT HEATER NO.1	PROPOSED PROPOSED	PANE L M OTOR	107 116	NA NA	3+ 1/20	~15 0.8	208	3	30	3	20-4G 20-2G		3HP TBD	MC	MCP NFMP		NA NA	EC	HVAC-TCP-1 TBD BY MC	DISCRETE SIGNAL TBD BY MC	TBD BYMC	HVAC-TCP-1 TBD BY MC	ANALOG SIGNAL TBD BY M C	TBD BY MC	LP-L4A OR B	208/120 VAC 120VAC	30-4G 20-2G	1,3,5,7
UH-2	UNIT HEATER NO.2	PROPOSED	M OTOR	116	NA	1/20	0.8	120	1	20	1	20-2G	TBD	TBD	MC	NEMP	20	NA	EC	TBD BY MC	TBD BY MC	TBD BYMC	TBD BY MC	TBD BYMC	TBD BY MC	LP-L4A OR B	120VAC	20-2G	1,3,5,8 1,3,5,8
UH-3	UNIT HEATER NO.3 UNIT HEATER NO.4	PROPOSED	M OTOR M OTOR	116	NA NA	1/20	0.8	120	1	20	1 1	20-2G 20-2G	TBD TBD	TBD TBD	M C M C	NEMP NEMP	20	NA NA	EC	TBD BY MC	TBD BY MC	TBD BYMC TBD BYMC	TBD BY MC TBD BY MC	TBD BYMC TBD BYMC	TBD BY MC	LP-L4A OR B LP-L4A OR B	120VAC 120VAC	20-2G 20-2G	1,3,5,8 1,3,5,8
UH-5	UNIT HEATER NO.5	PROPOSED	MOTOR	117	NA	1/20	2	120	1	20	1	20-2G	TBD	TBD	MC	NEMP	20	NA	EC	TBD BY MC	TBD BY MC	TBD BYMC	TBD BY MC	TBD BYMC	TBD BY MC	LP-L4A OR B	120VAC	20-2G	1,3,5,8
UH-6	UNIT HEATER NO.6	PROPOSED	M OTOR	218	NA	1/20	0.8	120	1	20	11	20-2G	TBD	TBD	MC	NEMP	20	NA	EC	TBD BY MC	TBD BY MC	TBD BYMC	TBD BY MC	TBD BYMC	TBD BY MC	LP-L4A OR B	120VAC	20-2G	1,3,5,8
UH-8	UNIT HEATER NO.7 UNIT HEATER NO.8	PROPOSED PROPOSED	MOTOR	218 218	NA NA	1/20	0.8	120	1	20	1	20-2G	TBD	TBD	MC	NFMP NFMP	20	NA NA	EC	TBD BY MC	TBD BY MC	TBD BYMC	TBD BY MC TBD BY MC	TBD BYMC TBD BYMC	TBD BY MC	LP-L4A OR B LP-L4A OR B	120VAC 120VAC	20-2G	1,3,5,8 1,3,5,8 1,3,5,8
UH-9	UNIT HEATER NO.9	PROPOSED	MOTOR	100	31.25	NA	0.26	120	1	20	1	20-2G	TBD	TBD	MC	NEMP	20	NA	EC	TBD BY MC	TBD BY MC	TBD BYMC	TBD BY MC	TBD BYMC	TBD BY MC	LP-L4A OR B	120VAC	20-2G	1,3,5,8
UH-10 UH-11	UNIT HEATER NO.10 UNIT HEATER NO.11	PROPOSED PROPOSED	M OTOR M OTOR	E. ENTRY		NA 1/20	0.26	120 120	1	20	1	20-2G 20-2G	TBD TBD	TBD TBD	M C	NEMP NEMP	20	NA NA	EC	TBD BY MC	TBD BY MC	TBD BYMC	TBD BY MC TBD BY MC	TBD BYMC TBD BYMC	TBD BY MC	LP-L4A OR B LP-L4A OR B	120VAC 120VAC	20-2G 20-2G	1,3,5,8 1,3,5,8
UH-12	UNIT HEATER NO.12	PROPOSED	M OTOR	112	NA	1/20	0.8	120	1	20	1	20-2G	TBD	TBD	MC	NEMP	20	NA	EC	TBD BY MC	TBD BY MC	TBD BYMC	TBD BY MC	TBD BYMC	TBD BY MC	LP-L4A OR B	120VAC	20-2G	1,3,5,8 1,3,5,8
UH-13 UH-14	UNIT HEATER NO.13 UNIT HEATER NO.14	PROPOSED PROPOSED	M OTOR M OTOR	115 113	NA NA	1/20	0.8	120 120	1	20	1	20-2G 20-2G	TBD	LBD IRD	M C	NFMP NFMP	20	NA NA	EC EC	TBD BY MC	TBD BY MC TBD BY MC	TBD BYMC	TBD BY MC TBD BY MC	TBD BYMC TBD BYMC	TBD BY MC	LP-L4A OR B LP-L4A OR B	120VAC 120VAC	20-2G 20-2G	1,3,5,8 1,3,5,8
UH-15	UNIT HEATER NO.15	PROPOSED	MOTOR	212	31.25	NA	0.26	120	1	20	1	20-2G	TBD	TBD	MC	NEMP	20	NA	EC	TBD BY MC	TBD BY MC	TBD BYMC	TBD BY MC	TBD BYMC	TBD BY MC	LP-L4A OR B	120VAC	20-2G	1,3,5,8 1,3,5,8
UH-16 UH-17	UNIT HEATER NO.16 UNIT HEATER NO.17	PROPOSED PROPOSED	M OTOR M OTOR	212	31.25 20	NA NA	0.26	120	1	20	1 1	20-2G 20-2G	TBD	TBD	M C	NFMP NFMP		NA NA	EC EC	TBD BY MC	TBD BY MC	TBD BYMC TBD BYMC	TBD BY MC TBD BY MC	TBD BYMC	TBD BY MC	LP-L4A OR B LP-L4A OR B	120VAC 120VAC	20-2G 20-2G	1,3,5,8 1,3,5,8
UH-18	UNIT HEATER NO.18	PROPOSED	M OTOR	N. FILTER	NA	1/20	0.8	120	1	20	1	20-2G	TBD	TBD	MC	NEMP	20	NA	EC	TBD BY MC	TBD BY MC	TBD BYMC	TBD BY MC	TBD BYMC	TBD BY MC	LP-L4A OR B	120VAC	20-2G	1,3,5,8 1,3,5,8
UH-19	UNIT HEATER NO.19 UNIT HEATER NO.20	PROPOSED PROPOSED	M OTOR M OTOR	N. FILTER		1/20	0.8	120	1	20	1	20-2G 20-2G	TBD	TBD	M C	NEMP NEMP		NA NA	EC	TBD BY MC	TBD BY MC	TBD BYMC	TBD BY MC TBD BY MC	TBD BYMC	TBD BY MC	LP-L4A OR B LP-L4A OR B	120VAC 120VAC	20-2G 20-2G	1,3,5,8
UH-20 UH-21	UNIT HEATER NO.21	PROPOSED	MOTOR	N. FILTER	NA	1/20	0.8	120	1	20	1	20-2G	TBD	TBD	MC	NEMP	20	NA	EC	TBD BY MC	TBD BY MC	TBD BYMC	TBD BY MC	TBD BYMC	TBD BY MC	LP-L4A OR B	120VAC	20-2G 20-2G	1,3,5,8 1,3,5,8
UH-22	UNIT HEATER NO.22 UNIT HEATER NO.23	PROPOSED	MOTOR	S. FILTER		1/20	0.8	120	1	20	1	20-2G	TBD	TBD	MC	NFMP NFMP		NA NA	EC	TBD BY MC TBD BY MC	TBD BY MC TBD BY MC	TBD BYMC TBD BYMC	TBD BY MC	TBD BYMC TBD BYMC	TBD BY MC	LP-L4A OR B LP-L4A OR B	120VAC	20-2G	1,3,5,8 1,3,5,8
UH-24	UNIT HEATER NO.24	PROPOSED	MOTOR	S. FILTER	NA	1/20	0.8	120	1	20	1	20-2G	TBD	TBD	MC	NEMP	20	NA	EC	TBD BY MC	TBD BY MC	TBD BYMC	TBD BY MC	TBD BYMC	TBD BY MC	LP-L4A OR B	120VAC 120VAC	20-2G	1,3,5,8
UH-25 UH-26	UNIT HEATER NO. 25 UNIT HEATER NO. 26	PROPOSED PROPOSED	M OTOR M OTOR	S. FILTER		1/20 NA	0.8	120 120	1	20	1	20-2G 20-2G	TBD TBD	TBD TBD	M C M C	NFMP NFMP		NA NA	EC	TBD BY MC	TBD BY MC	TBD BYMC	TBD BY MC	TBD BYMC	TBD BY MC	LP-L4A OR B	120VAC 120VAC	20-2G	1,3,5,8 1,3,5,8 1,3,5,8
XFMR-L4B	L4B TRANSFORMER	PROPOSED	XFMR	106	30	NA NA	0.26 NA	480	3	50	3	50-4G		NA	NA NA	CB		NA NA	EC	IDD BY MC	IBD BY MC	IDDBYMC	I BU BY MC	IDD BYMC	TOD BY MC	PP-1	120VAC 480 VAC	20-2G 50-3G	1,3,5,8
LP-L4B	LIGHTING AND APPLIANCE PANEL L4B	PROPOSED	PANEL	116	NA	NA	NA	208/120	3	100	3	100-4G	NA	NA	NA	MANCE	100	NA	EC							LW-XFMR-L4B	208/120 VAC	100-4G	10
LP-L4A HVAC-TCP-1	LIGHTING AND APPLIANCE PANEL L4A HVAC TEMPERATURE CONTROL PANEL	EXISITNG PROPOSED	PANE L PANE L	116 107	NA 2	NA NA	NA 13.3	208/120	1	60 20	2	60-3G 20-3G	NA NA	NA NA	NA NA	CB CB		NA NA	EC EC				+		1	LP-L4B LP-L4B	208/120 VAC 208/120 VAC	100-3G 100-3G	11
HVAC-MDDC-1	HVAC MASTER DDC CONTROL PANEL	PROPOSED	PANEL	203A	1	NA	6.75	120	1	20	1	20-3G	NA	NA	NA	CB	20	NA	EC							LP-L2	208/120 VAC	100-3G	10
XFMR-LP-1 LP-L1	LP-L1 LAB TRANSFORMER LP-L1 LAB LIGHTING PANEL	PROPOSED EXISTING	XFMR PANE L	203A 208	25	NA NA	NA 150	480 240/120	1	70 150	2	70-3G 150-3G	NA NA	NA NA	NA NA	CB CB		NA NA	EC							PP-1 XFMR-LP-L1	480 VAC 240/120 VAC	70-3G 150-3G	10
XFMR-LP-3A	LP-L3A&B LAB TRANSFORMER	PROPOSED	XFMR	107	37.5	NA NA	NA NA	480	1	100	2	150-3G 100-3G		NA NA	NA NA				EC							PP-1	480 VAC	100-3G	10
LP-3A	LP-L3A LIGHTING PANEL	EXISTING	PANEL		L NA	NA	200	240/120	1	200	2	200-3G	NA	NA	NA	CB	100 200 300	NA	EC								240/120 VAC	200-3G	11
WTP-MCC-1	POWER PANEL NO.1 WATER TREATMENT PLANT MOTOR CONTROL CENTER	PROPOSED EXISITNG	PANE L PANE L	203A UPPER HALI	NA L NA	NA NA	300 300	480 480	3	300 NA	3	300-3G 600-3G		NA NA	NA NA	LUGS	300 600	NA NA	EC EC							WTP-MDS-1	480 VAC 480 VAC	300-3G 600-3G	11
							000	480	-	600	_						000		EC							EXISTING			
WTP-MDS-1	WATER TREATMENT PLANT MAIN DISCONNECT SWITCH	PROPOSED	PANEL	EXTERIOR	NA	NA	600	480	3	600	3	600-3G	NA	NA	NA	CR	600	NA	EC	1						SERVICE XFMR	400 VAC	600-3G	10

- WITE TREATMENT SCHOOL GENERAL NOTES:

  1. ALL WORK BY THIS CONTRACTOR SHALL BE RESPONSIBLE FOR COORDINATION WITH OTHER TRADES TO AVOID CONFLICTS AND TO VERFY ALL EQUIPMENT CONNECTION REQUIREMENTS.

  2. THIS CONTRACTOR SHALL BE RESPONSIBLE FOR INSTALLING A COMPLETE ELECTRICAL SYSTEM FOR ALL OWNER-PURINSHED AND INSURING THAT THE SYSTEM IS OPERATIONAL UPON JOB COMPLETON.

  4. THIS CONTRACTOR SHALL BE RESPONSIBLE FOR INSTALLING A COMPLETE ELECTRICAL SYSTEM FOR ALL OWNER-PURINSHED APPLIANCES IN ACCORDANCE WITH NEXT ACCORDANCE WITH NEXT

NOTE (S):

CHECKED BY: SRC

- ELECTRICAL WRING SCHEDULE LEGEND:

  MOTOR CONTROLLERS:

  FVNR = FULL VOLITAGE NON-REVERSING STARTER (ACROSS THE LINE ELECTRONIC MAG STARTER)

  FVNR = FULL VOLITAGE REVERSING STARTER (ACROSS THE LINE ELECTRONIC MAG STARTER)

  2SP = 2-SPEED FULL VOLITAGE STARTER

  SRNV = SOUD STATE REDUCED VOLTAGE (REDUCED VOLTAGE SMART MOTOR CONTROLLER SOFT START)

  VFD = VARIABLE FREQUENCY DIRVE

- 1 DEMOLISH EXISTING
- 1. DEM OLISH EXISTING
  2. CONNECT NEW EQUIPMENT
  3. CONNECT NEW EQUIPMENT WITH NEW DISCONNECT RATED PLUGAREC SET (TYPICAL)
  4. REUSE SSSTING MOTOR FEEDERS
  5. REPLACE EXISTING MOTOR CIRCUIT, RACEWAY, ETC...AND CONNECT EQUIPMENT
  6. NO POWER CONNECTION EXPECTED (BY MC)
  7. RELOCATE EXISTING MOTOR CONTROLLER, REFEED TO PROPOSE D LOCATION
  8. CONTROL WRING BY MC
  9. NEW MOTOR CRCUIT, RACEWAY, ETC...AND CONNECTE QUIPMENT
  10. NEW FEEDER CRCUIT, RACEWAY, ETC...AND CONNECTE QUIPMENT
  11. NEW FEEDER CRCUIT, RACEWAY, ETC...AND CONNECTE GUIPMENT
  11. NEW FEEDER CRCUIT, RACEWAY, ETC...AND CONNECTE SISTING EQUIPMENT

ADDENDUM #1

WIRNG LEGEND:  $Ax = A A LOG S KINAL + 2C \pm 16 S HEILDED, TWISTED PAR) (x = \# OF TWISTED PAIRS) DX = DISCRETE SIGNAL + <math>\pm 14$  THHN WIRE (x = # OF WIRES) MX = MANUFACTURE CABLE (x = # OF CABLES) Ex = CAT56 (x = # OF CABLES) Ex = CAT56 (x = # OF CABLES)DISCONNECT:
F = FUSED
NF = NON-FUSED
NFM = NON-FUSED MOTOR PLUG AND RECEPTCLE
CB = CRCUIT BREAKER BY: GC = GENERAL CONTRACTOR EC = ELECTRICAL CONTRACTOR MC = MECHANICAL CONTRACTOR

I HEREBY CERTIFY THAT THIS PLAN, REPORT, OR SPECIFICAT	ION WAS PREPARED BY ME OF	R UNDER MY DIRECT	
SUPERVISION AND THAT I AM A DULY LICENSED PROFESSION	AL ENGINEER UNDER THE LAW	S OF THE STATE OF MINNESO	OTA.
Satt & Chilar	MARCH 25, 2016	44287	
SCOTT R. CHILSON	Date	License No.	



TRANSPORTATION • MUNICIPAL PRINCIPAL 332 W. Superior Street Duluth, MN 55802 218-722-3915 1-800-777-7380 Fax: 218-722-4548 Web Address: www.msa-ps.com e MSA Professional Services, Inc.

LAKEWOOD WTP HVAC SYSTEM IMPROVEMENTS CITY OF DULUTH LAKEWOOD, MN

ELECTRICAL SCHEDULES NO. 5

00616097 E-26R